


SCALE: 1" = 100'

1455 ZANESFIELD CORPORATION LINE

SEE PAGE 20

SEE PAGE 20

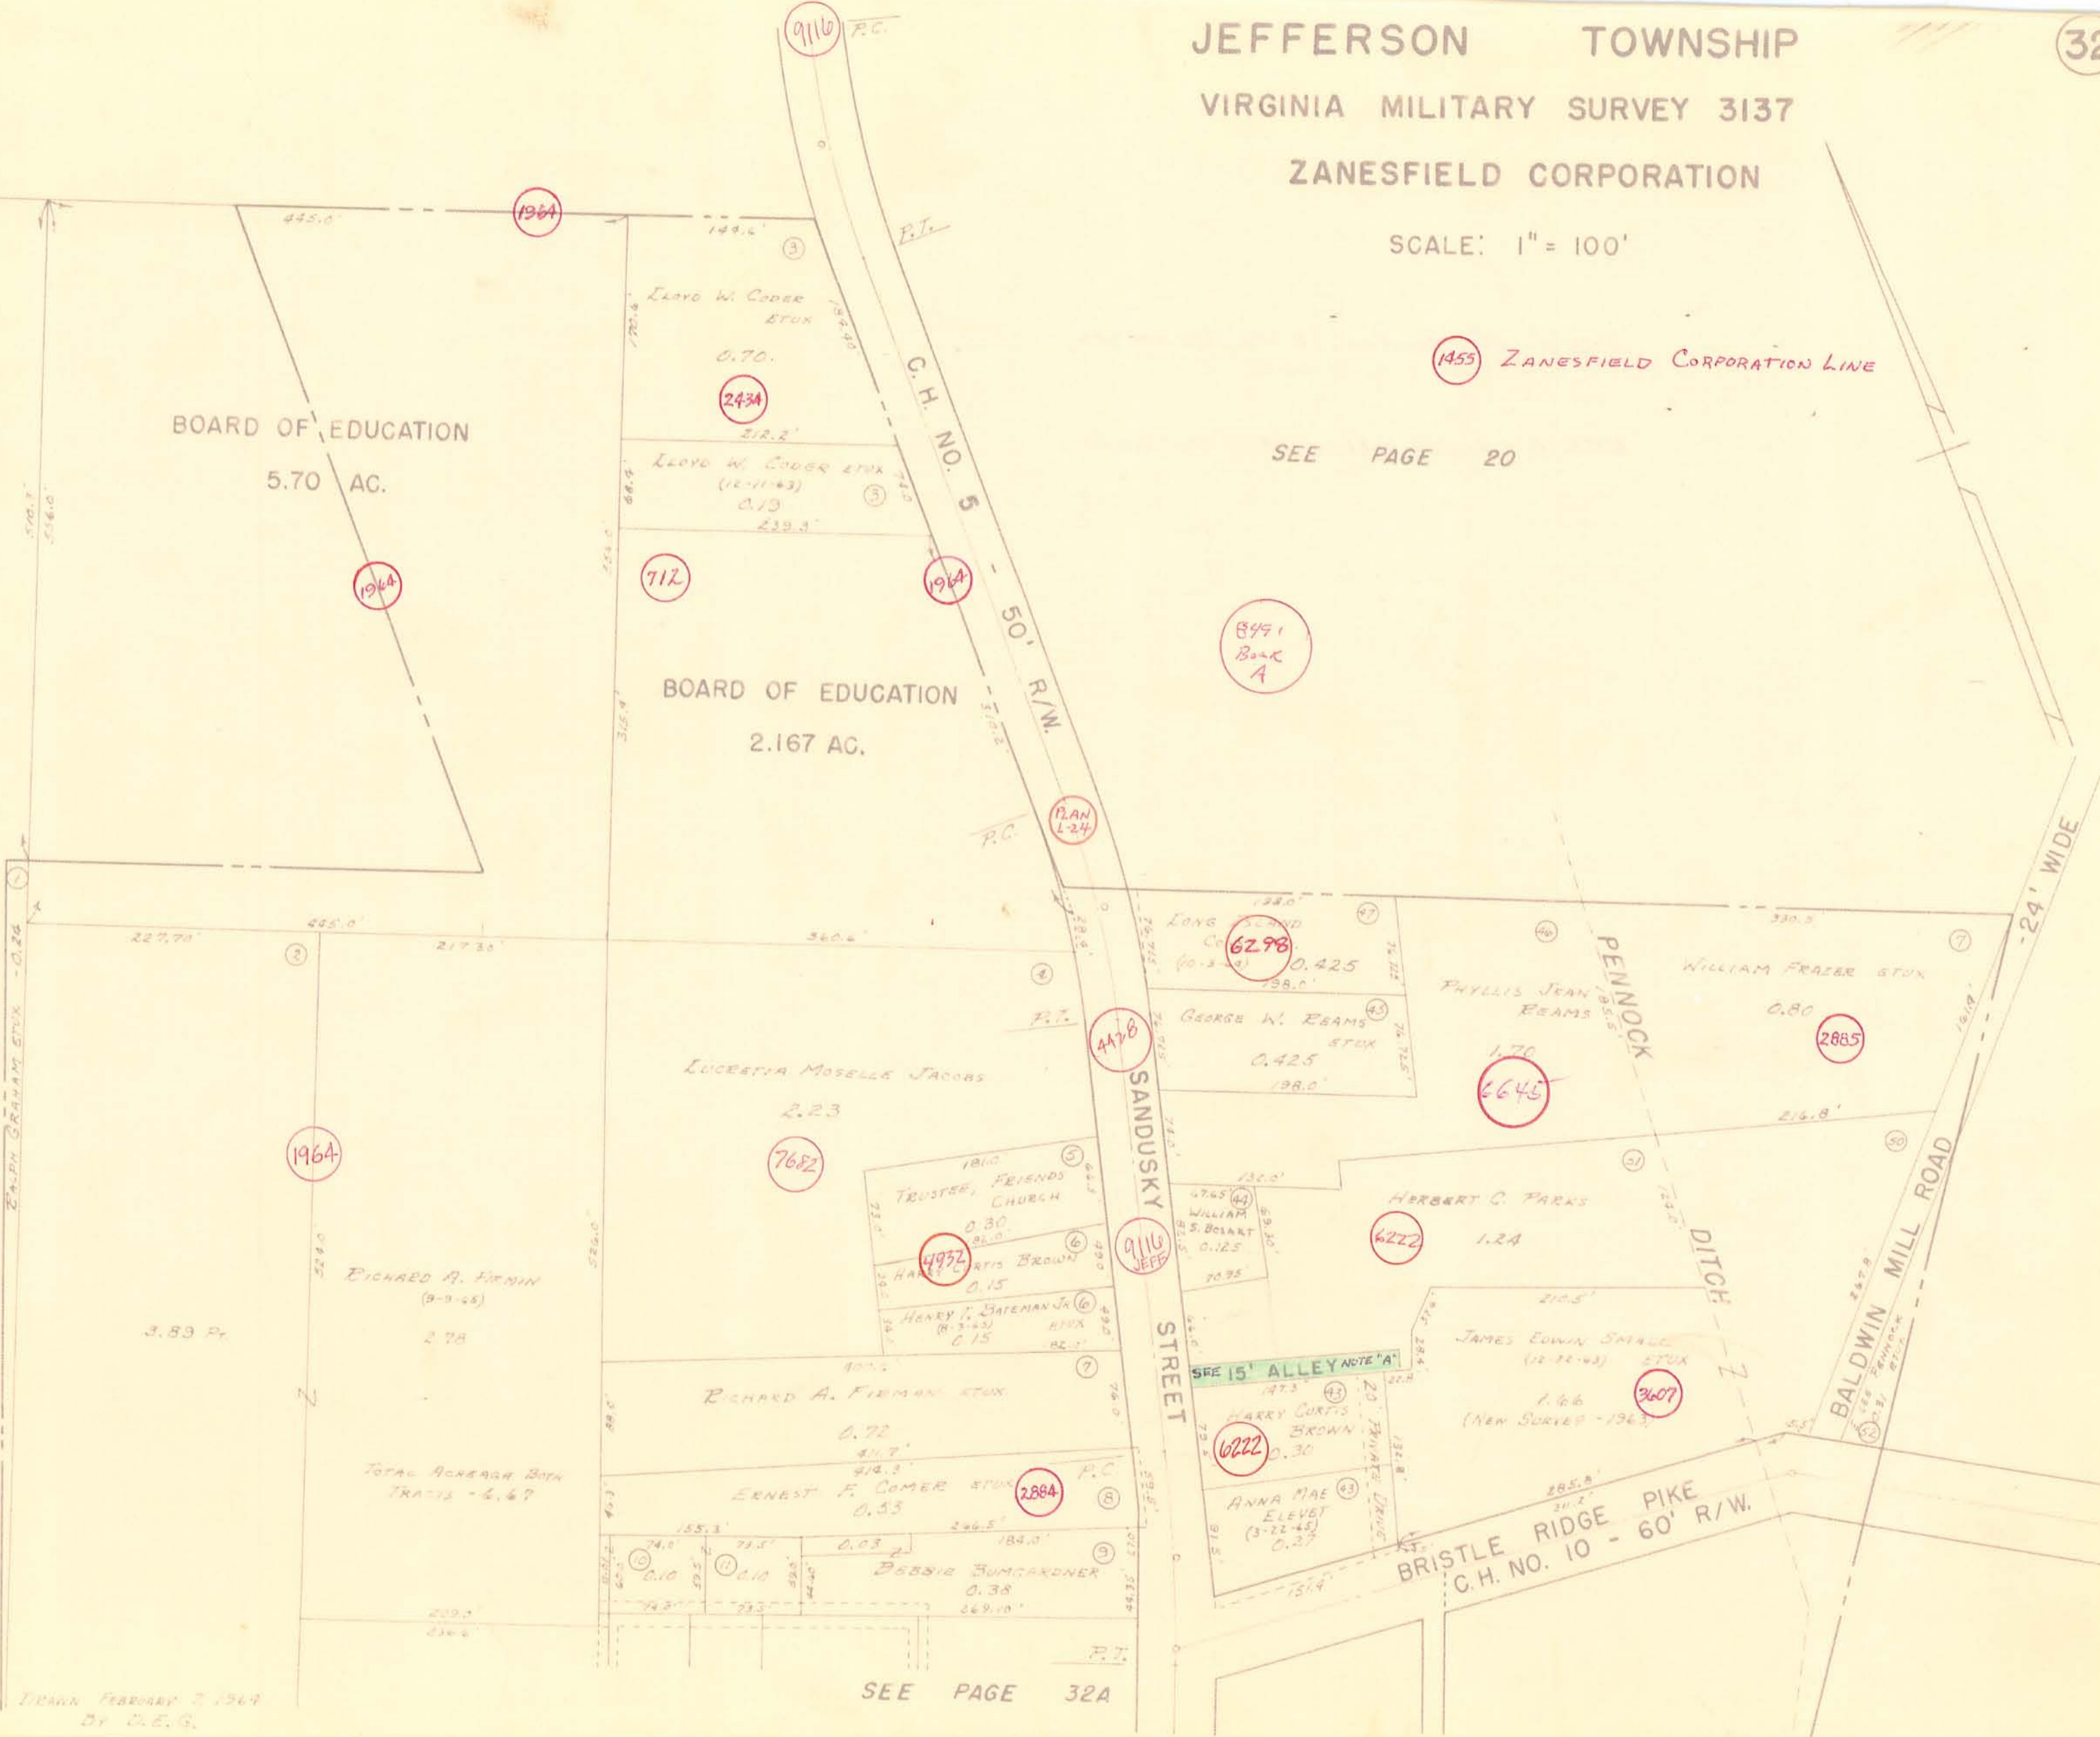

BOARD OF EDUCATION  
5.70 AC.

BOARD OF EDUCATION  
2.167 AC.

LUCRETIA MOSELLE JACOBS  
2.23

RICHARD A. FIRMEN  
(9-9-05)  
2.78

RICHARD A. FIRMEN STUX  
0.70

ERNEST F. COMER STUX  
0.53

BESSIE BURGARDNER  
0.38

LONG SAND  
CO. (10-3-03)  
0.425

GEORGE W. BEAMS  
STUX  
0.425

PHYLLIS JEAN  
BEAMS  
0.80

HERBERT C. PARKS  
1.24

JAMES EDWIN SMALLE  
(12-22-03) STUX  
1.46  
(NEW SURVEY - 1963)