MIAMI TOWNSHIP

SECTION 22 TOWN 1 RANGE 8
SECTION 27 TOWN 1 RANGE 8

SCALE 10 CHAINS TO THE INCH

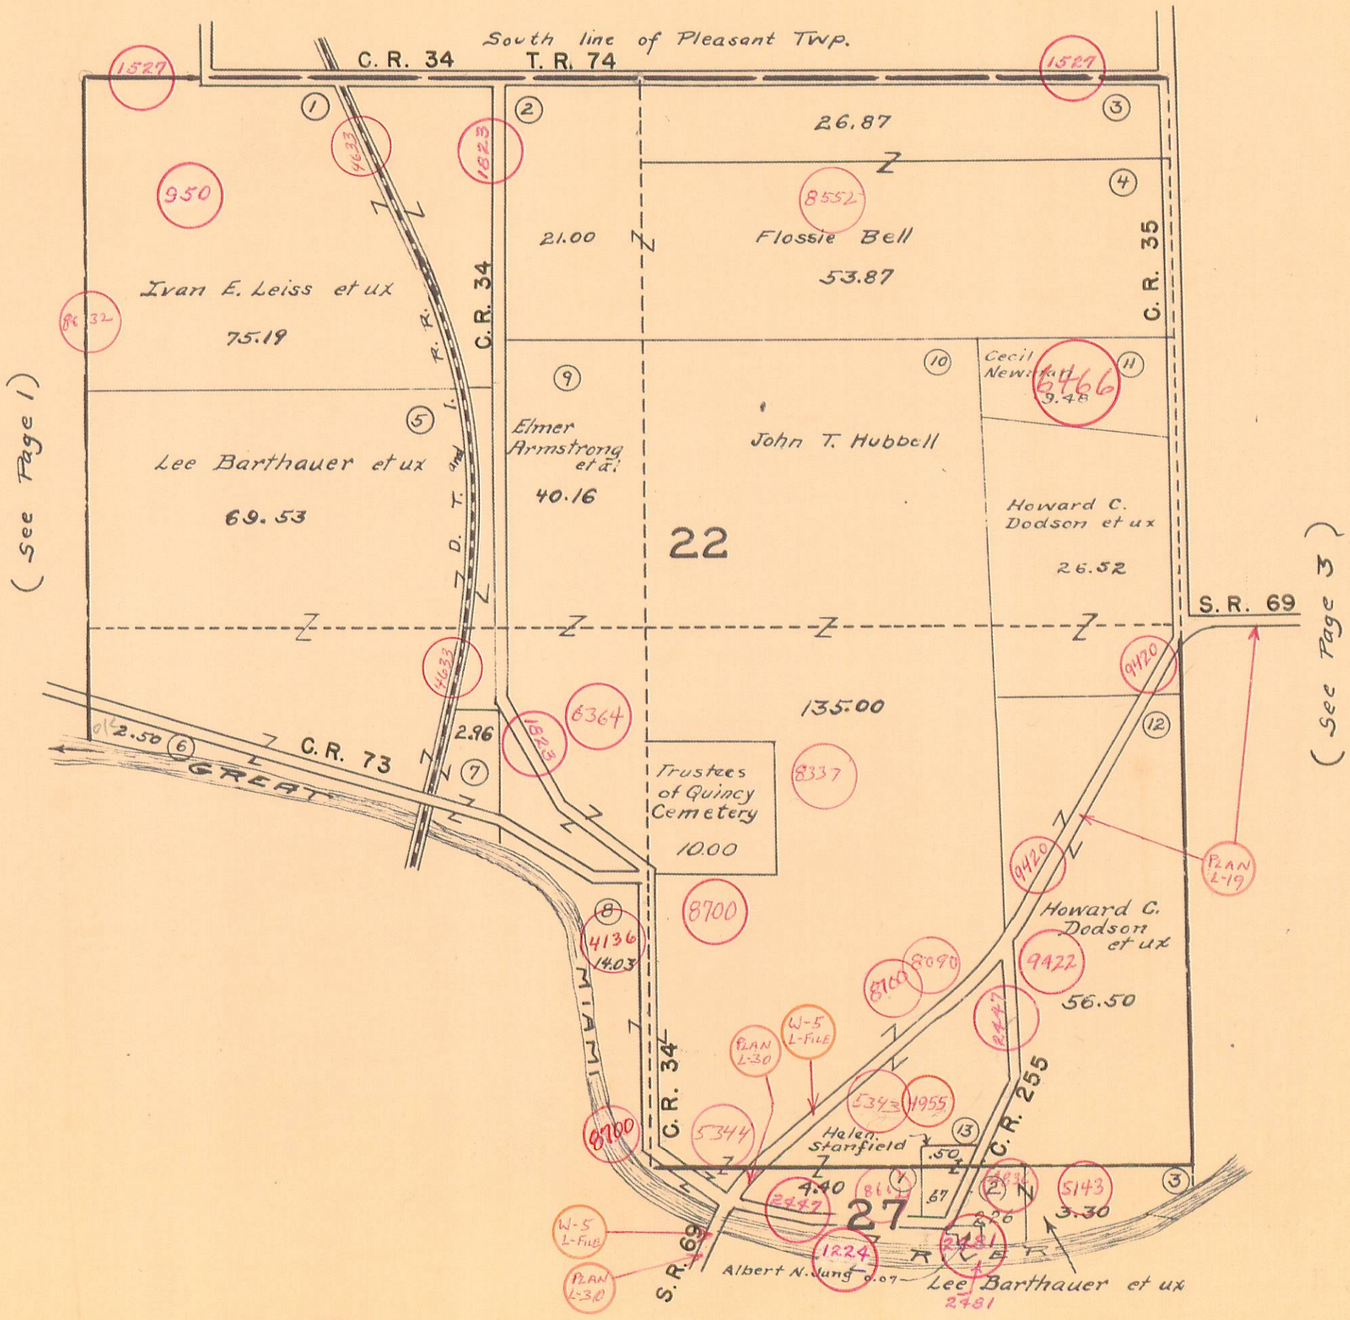

FFW GWW
1932 1942