


MIAMI TOWNSHIP
SECTION 29 TOWN 3 RANGE 13

SCALE 10 CHAINS TO THE INCH

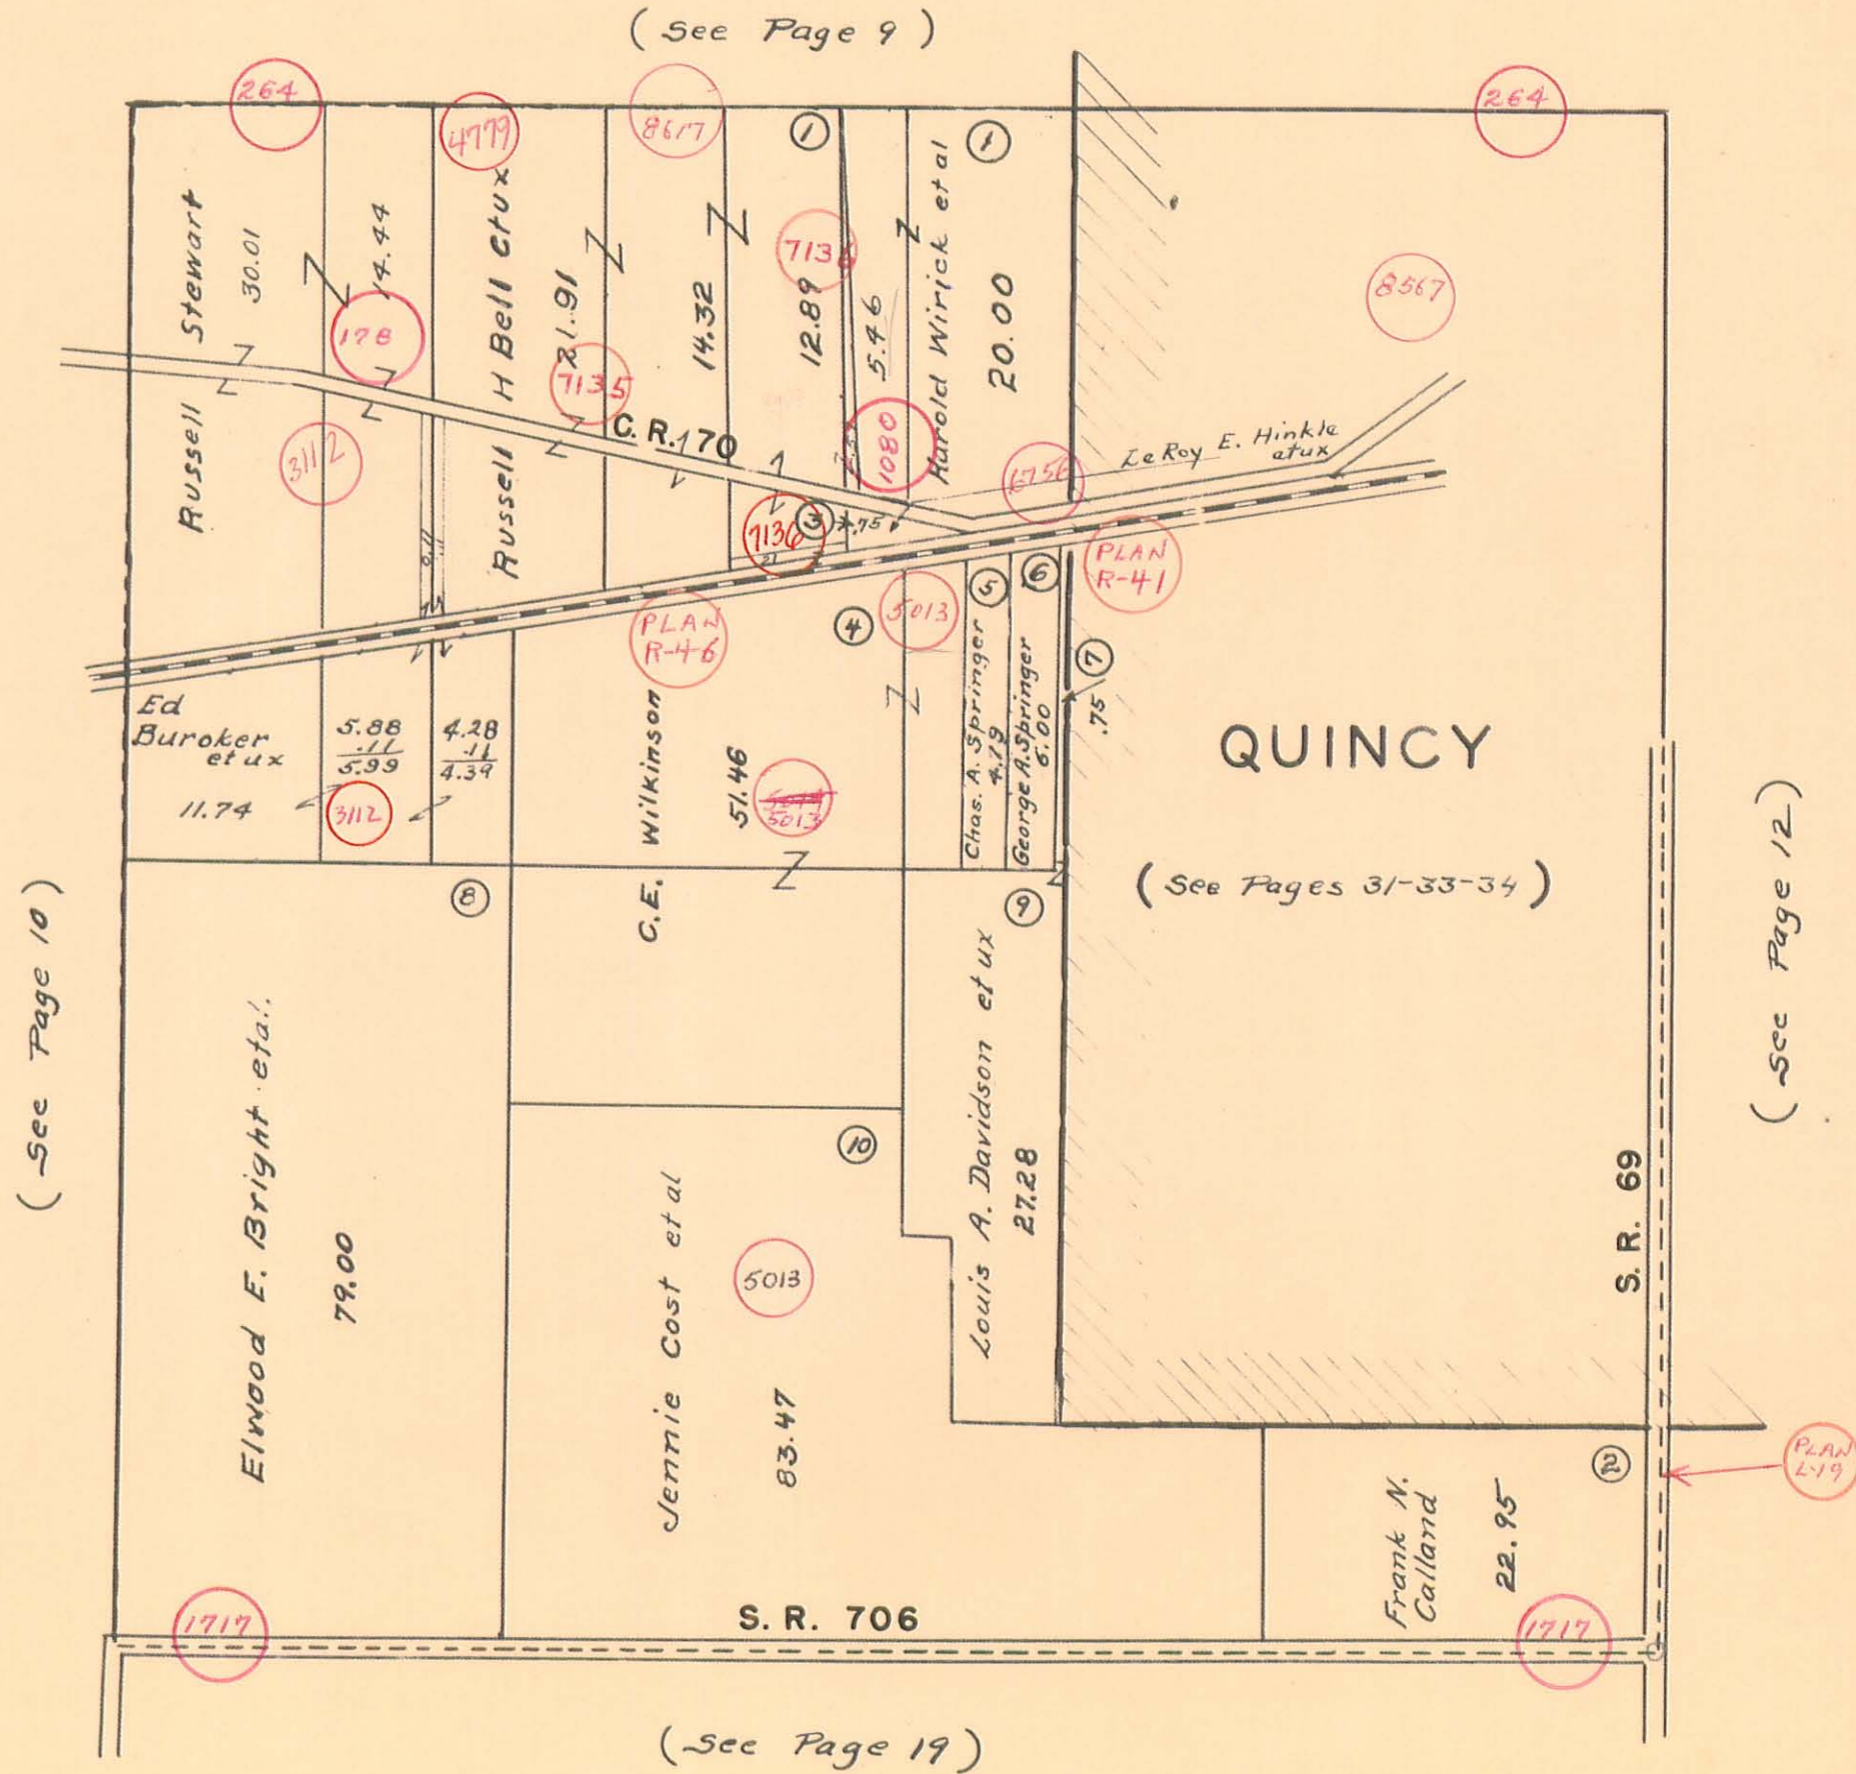

(See Page 9)

(See Page 10)

(See Page 12)

(See Page 19)