


MIAMI TOWNSHIP
QUINCY (S.E. PART)

SCALE 200 FEET TO THE INCH
SEC. 23 T. 3 R. 13

(See Page 32)

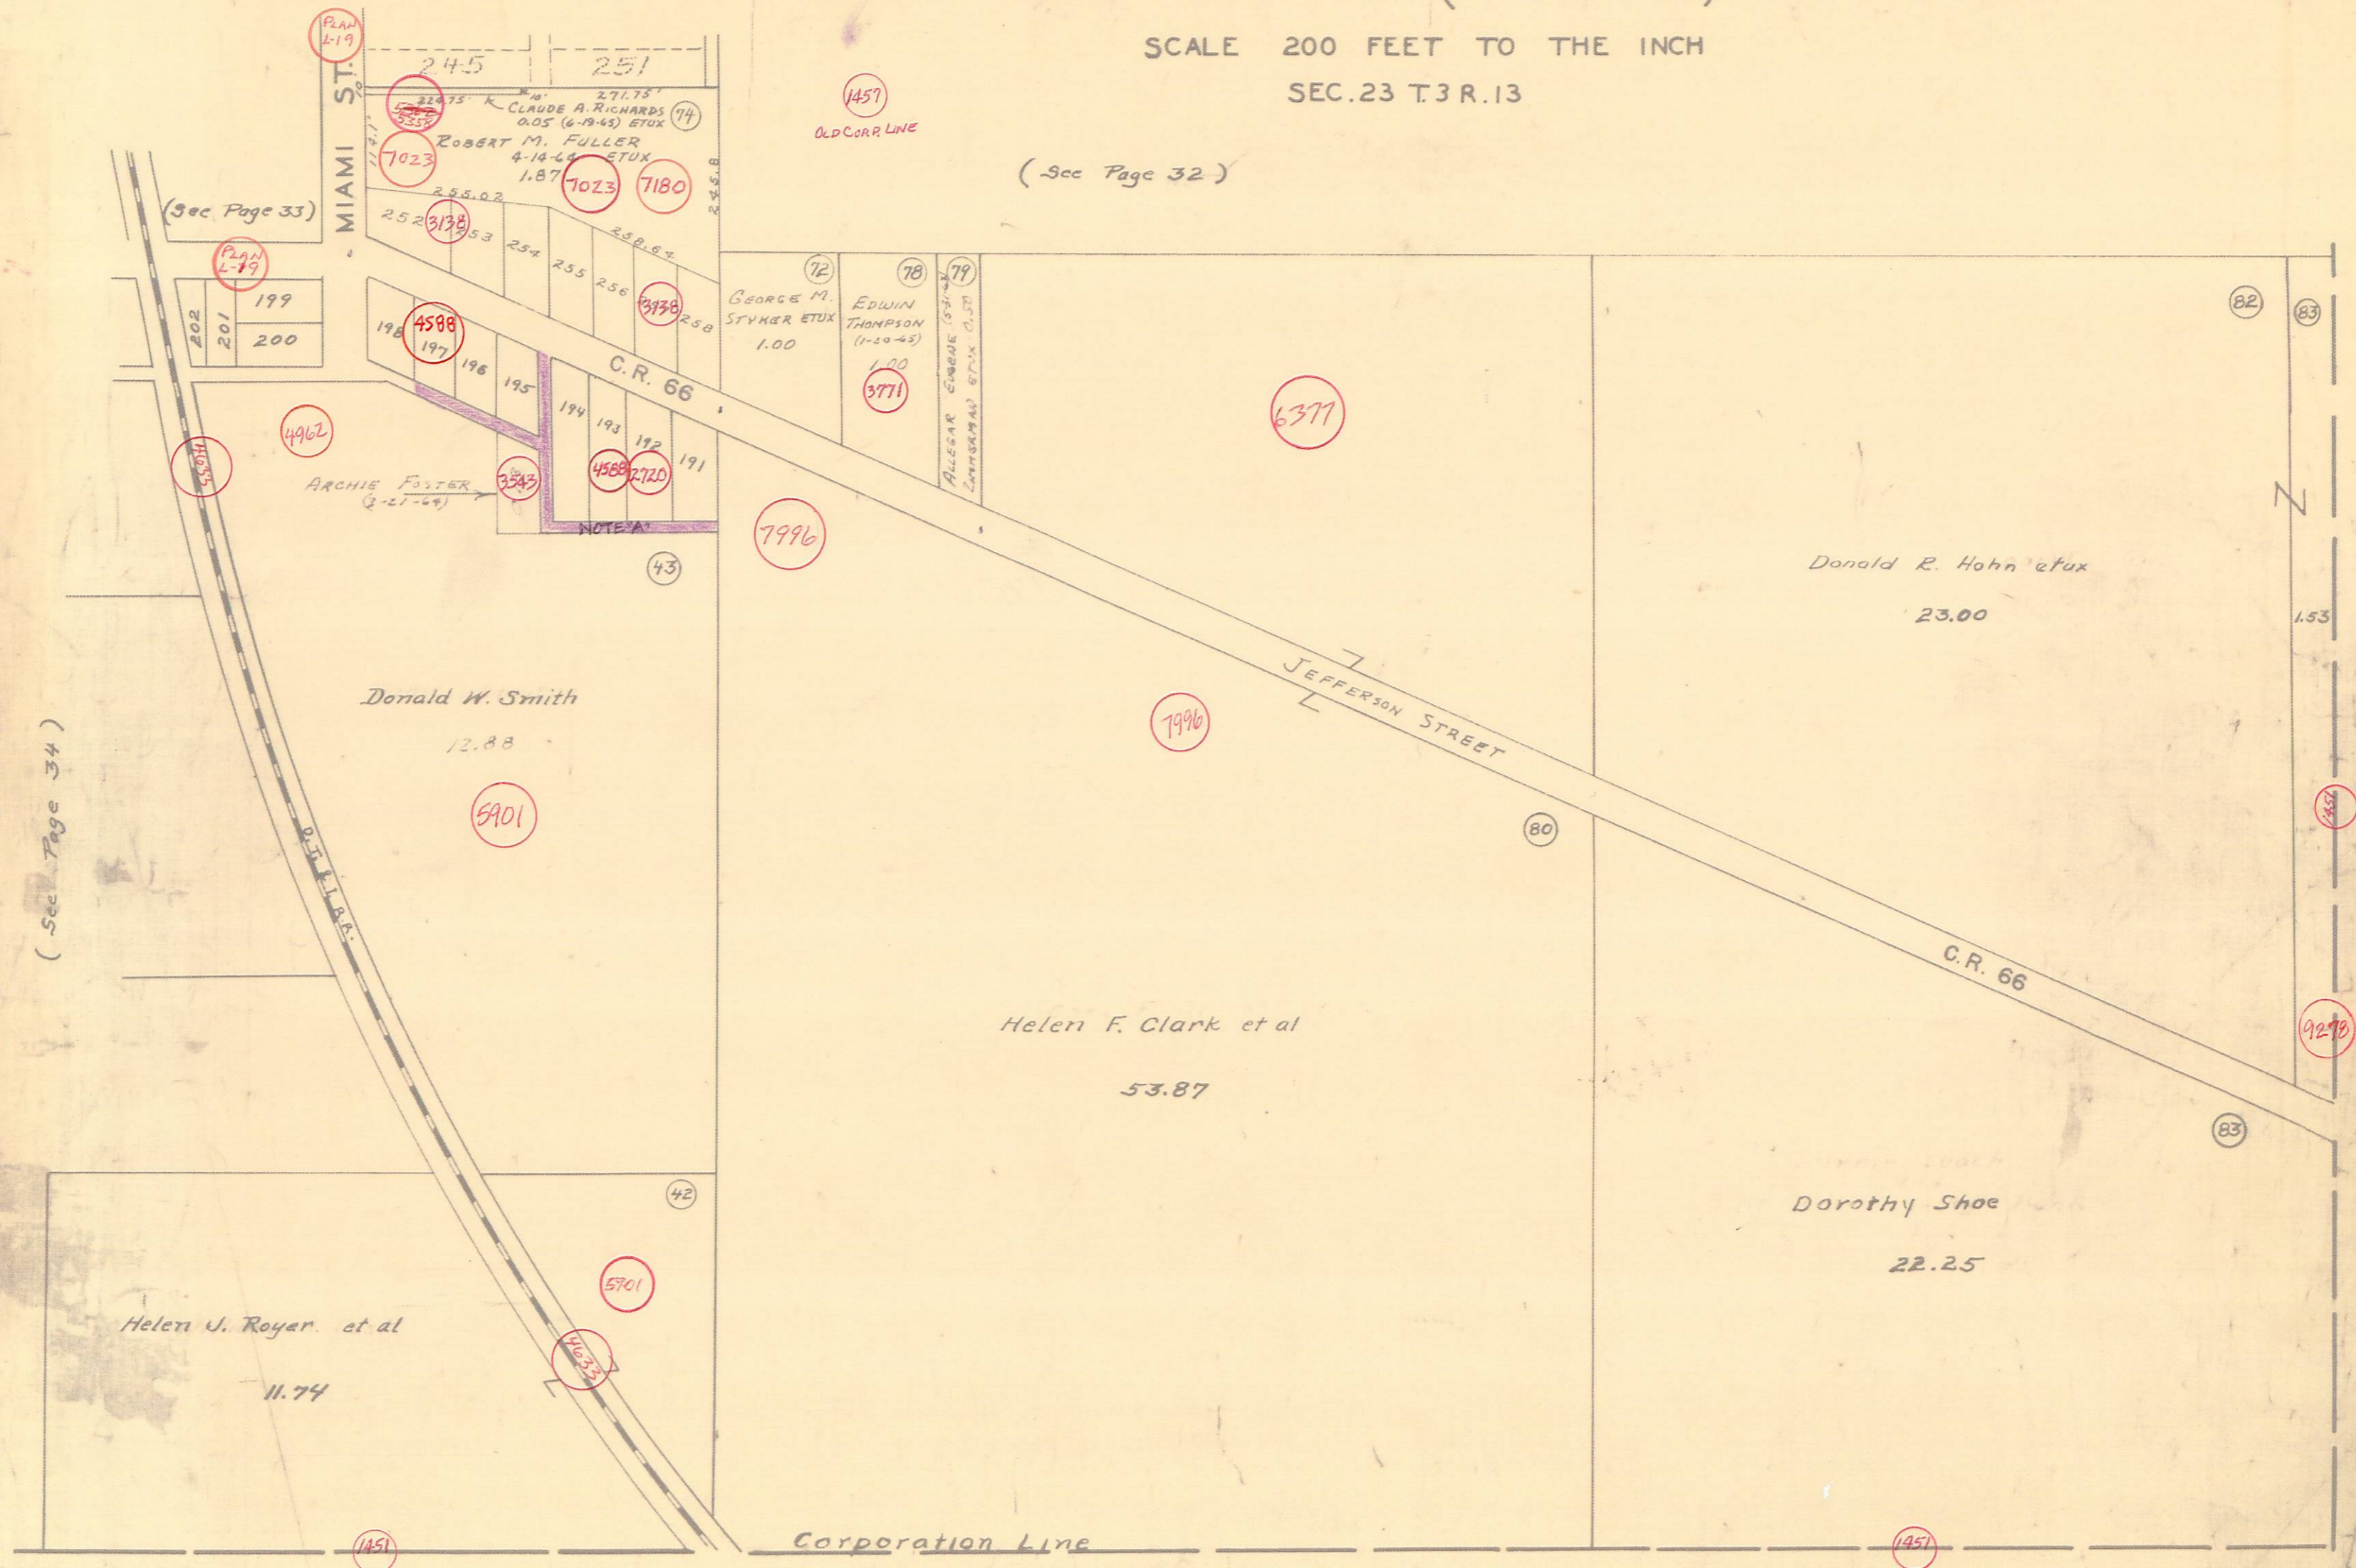

(See Page 33)

PLAN L-19

PLAN L-19

1457
OLD CORR. LINE

202
201
200

198
197

4962

ARCHIE FOSTER
(2-27-69)

Donald W. Smith
12.88

5901

7996

43

72
78
79
GEORGE M. STYKER ETUX
1.00
EDWIN THOMPSON
(1-20-45)
1.00
ALLEGAR EMBRE (59-1-10)
LAWSON ETUX (1-20-45)

3771

6377

7996

Helen F. Clark et al
53.87

80

Donald R. Hahn et ux
23.00

1.53

1457

9270

83

Dorothy Shoe
22.25

5901

Helen J. Royer et al
11.74

1457

Corporation Line

1457