


VIRGINIA MILITARY SURVEY 4479

SCALE 10 CHAINS TO THE INCH

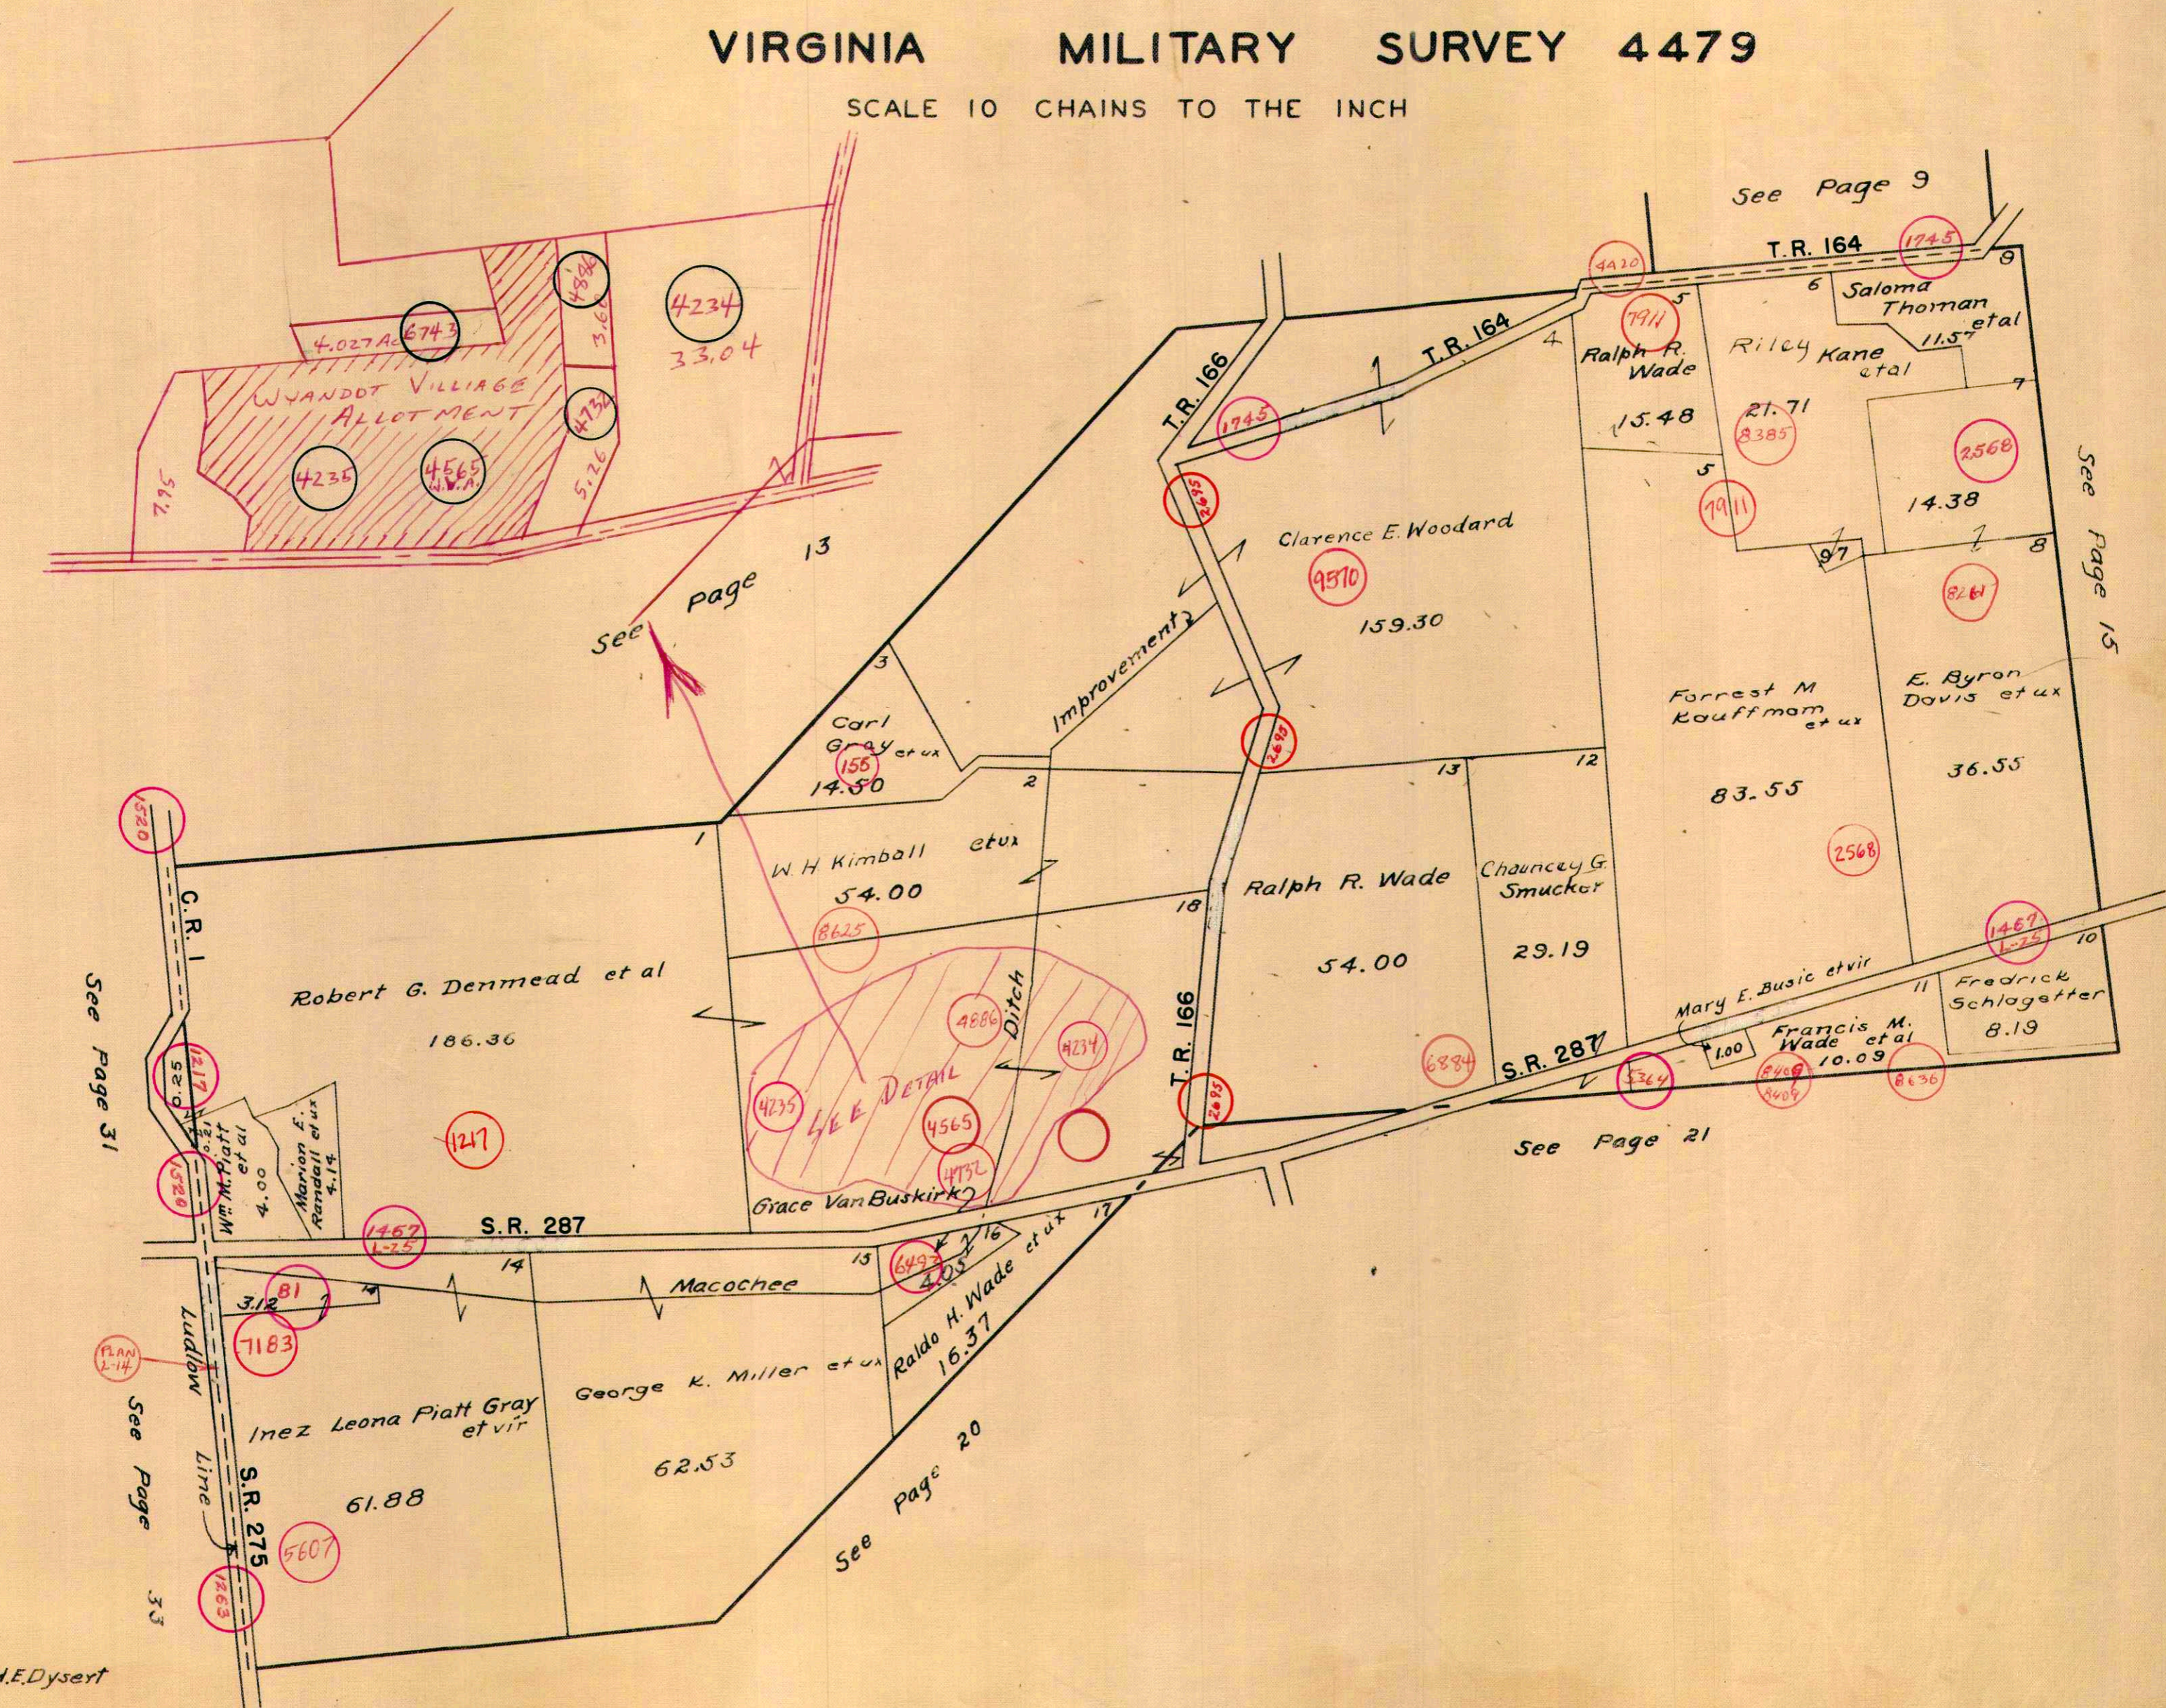

H.E. Dysert