


PERRY TOWNSHIP
VIRGINIA MILITARY SURVEYS 4813 4815

SCALE 10 CHAINS TO THE INCH

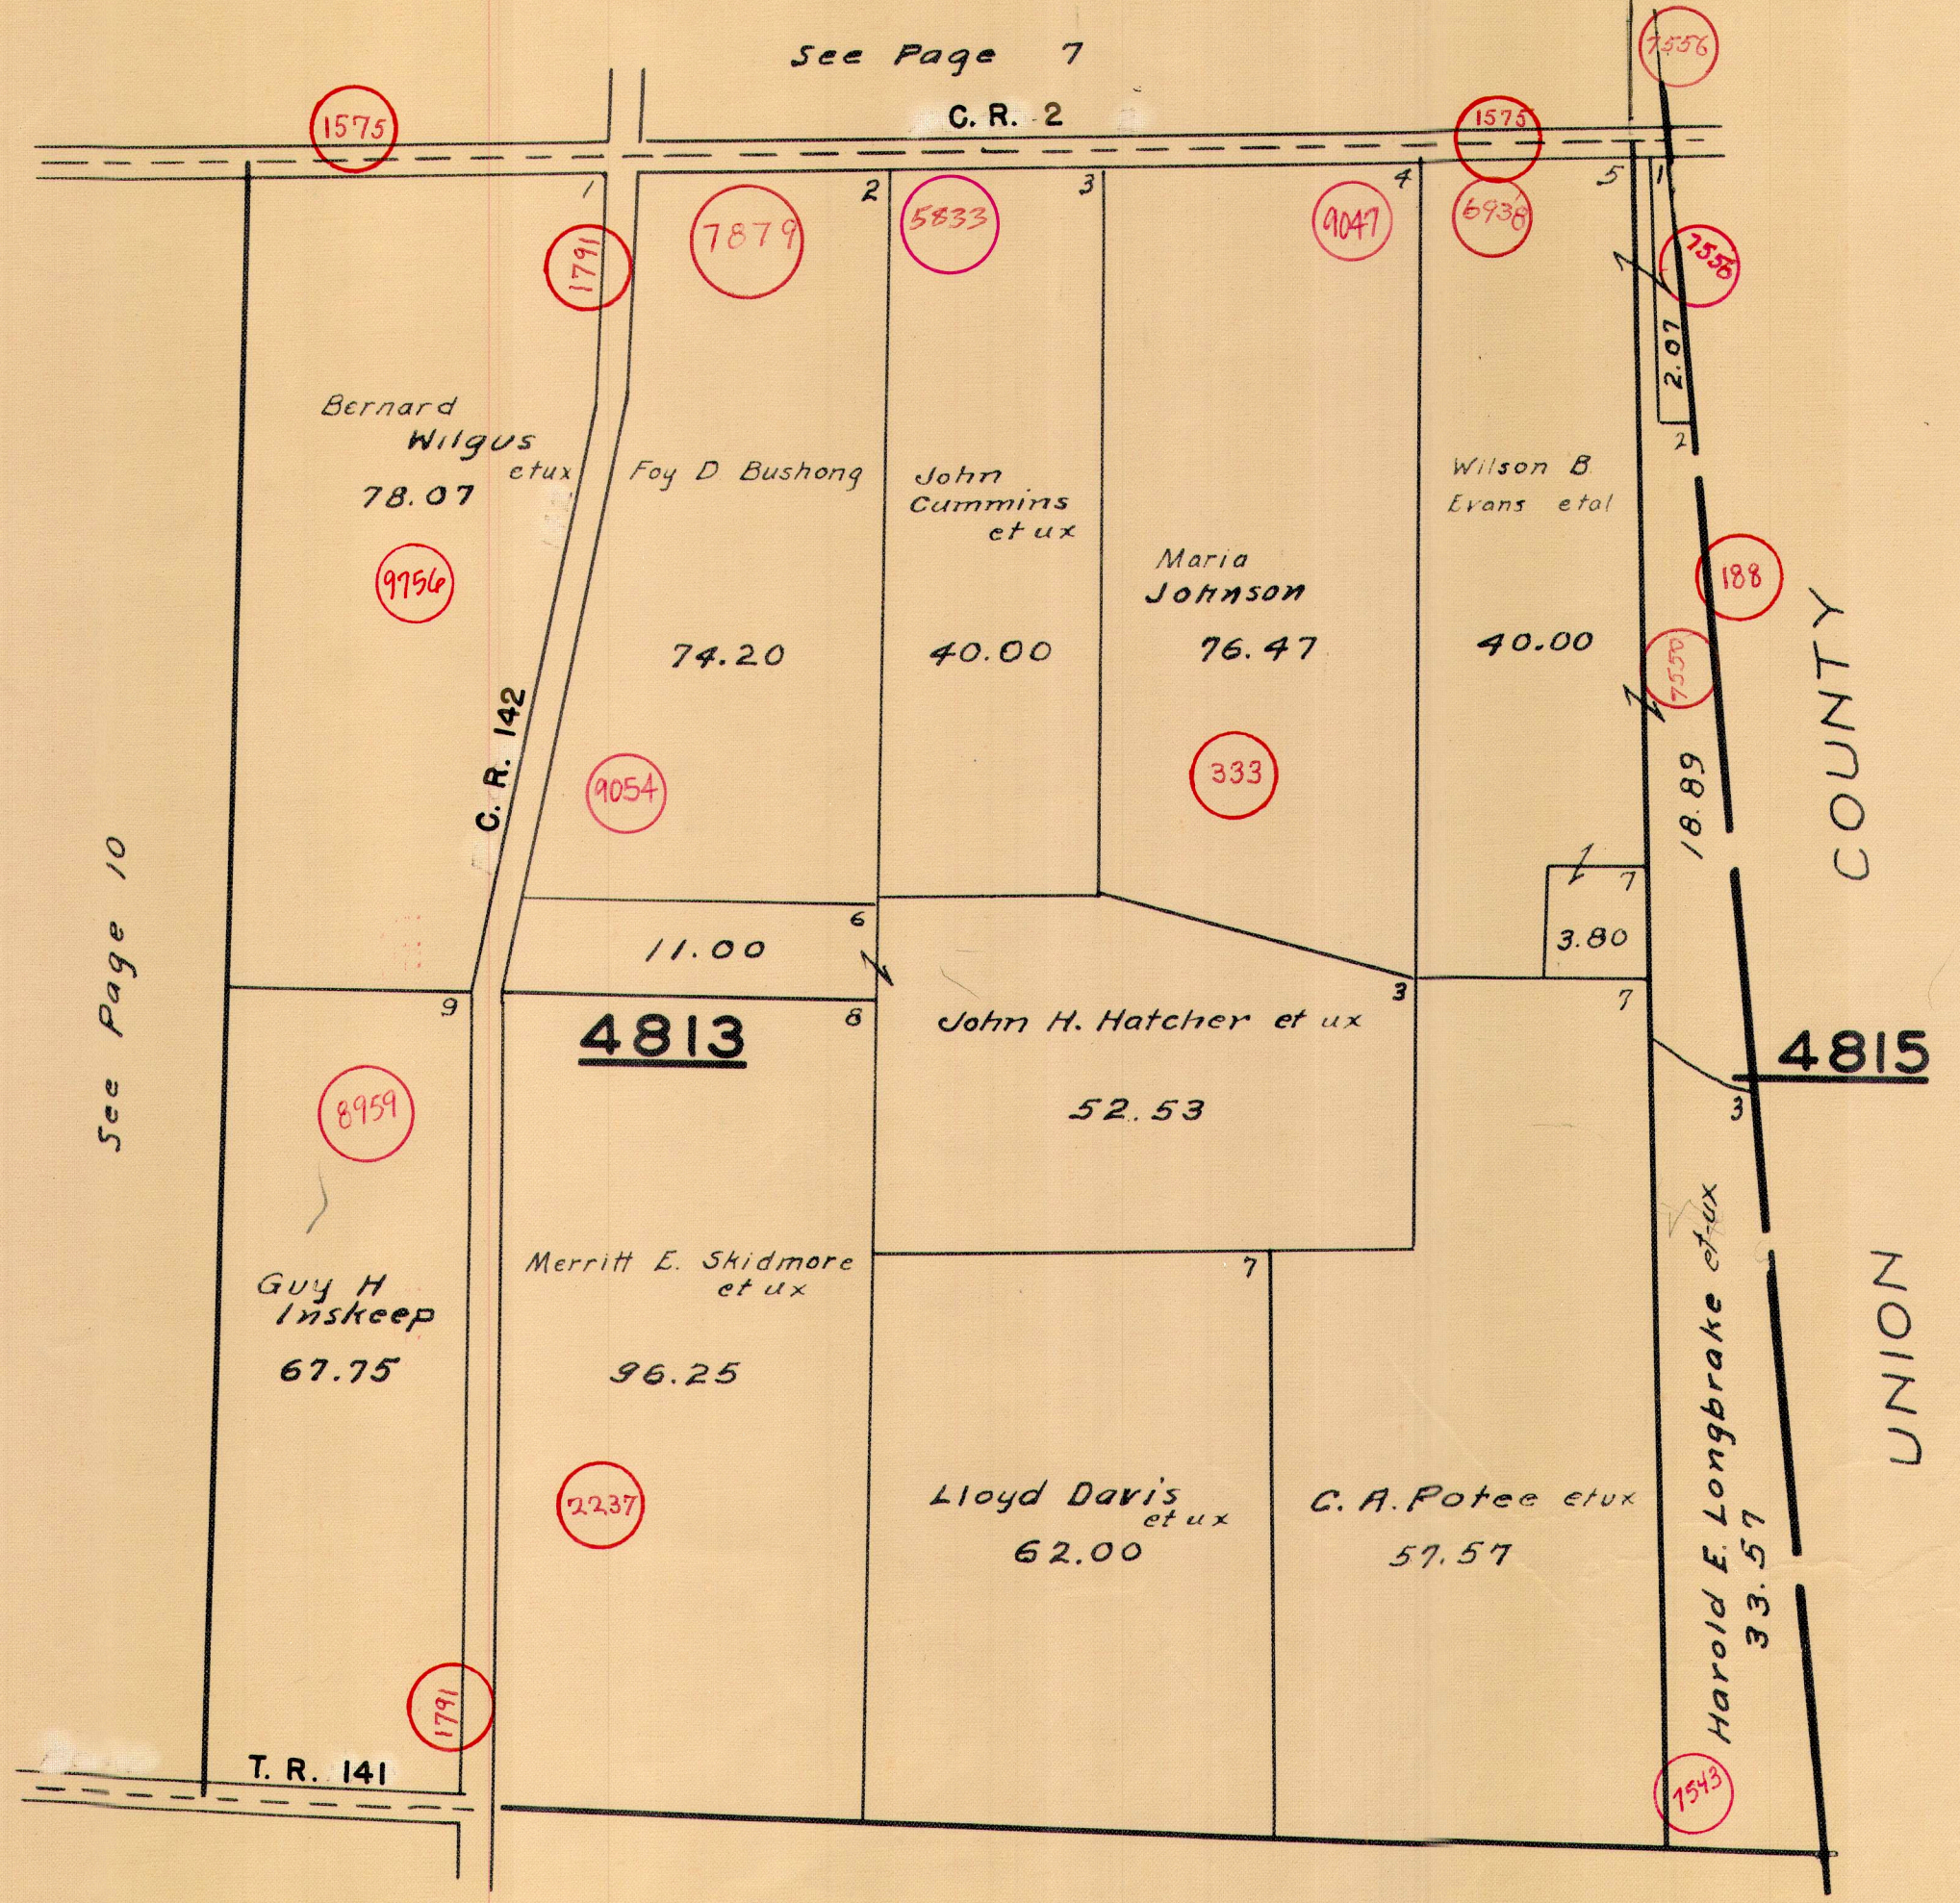

See Page 7

See Page 10

See Page 19

1575

1791

7879

5833

9047

1575

6938

7536

7536

9956

9054

333

188

7530

8959

2237

1791

7543

T. R. 141

4815

4813

Bernard Wilgus et ux
78.07

Foy D Bushong
74.20

John Cummins et ux
40.00

Maria Johnson
76.47

Wilson B Evans et al
40.00

11.00

John H. Hatcher et ux
52.53

Guy H Inskip
67.75

Merritt E. Skidmore et ux
96.25

Lloyd Davis et ux
62.00

C. A. Potee et ux
57.57

Harold E. Longbrake et ux
33.57

COUNTY

UNION