


RICHLAND TOWNSHIP
VIRGINIA MILITARY SURVEY 9969

SCALE 10 CHAINS TO THE INCH



See Page 17

C.R. 38

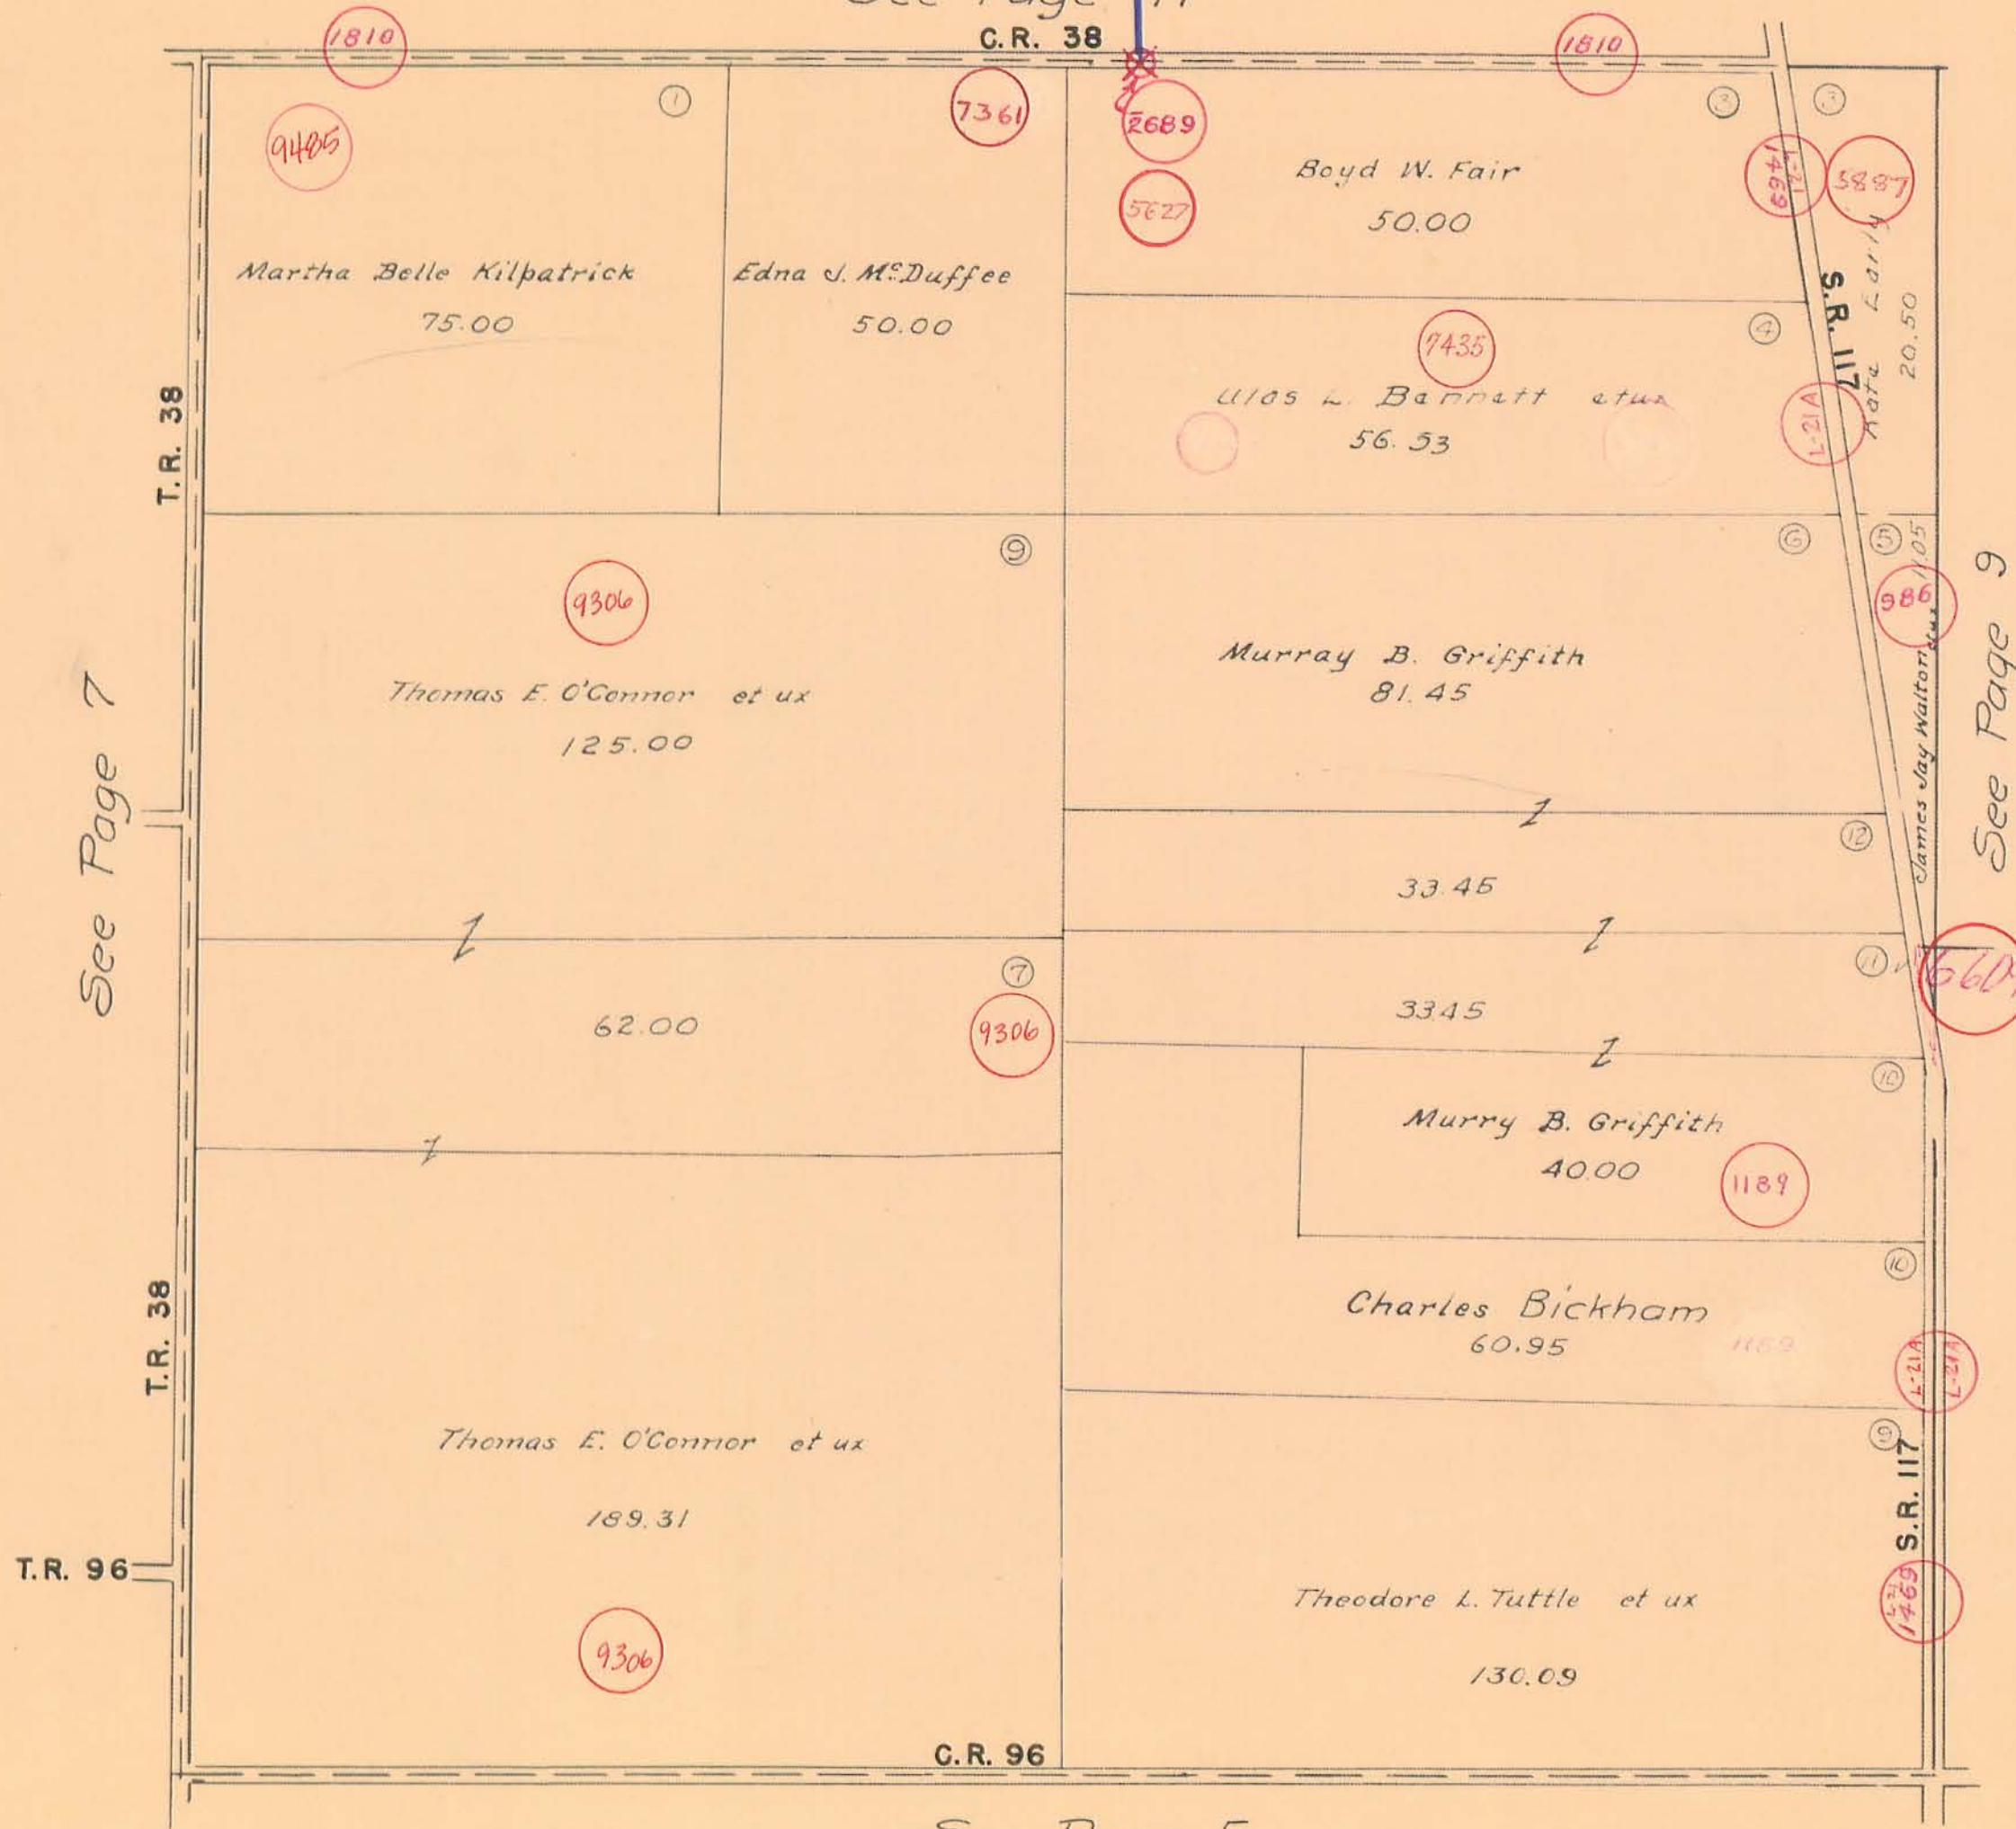

See Page 7

See Page 9

See Page 5