


RICHLAND TOWNSHIP  
VIRGINIA MILITARY SURVEYS

9989  
12181

SCALE 10 CHAINS TO THE INCH

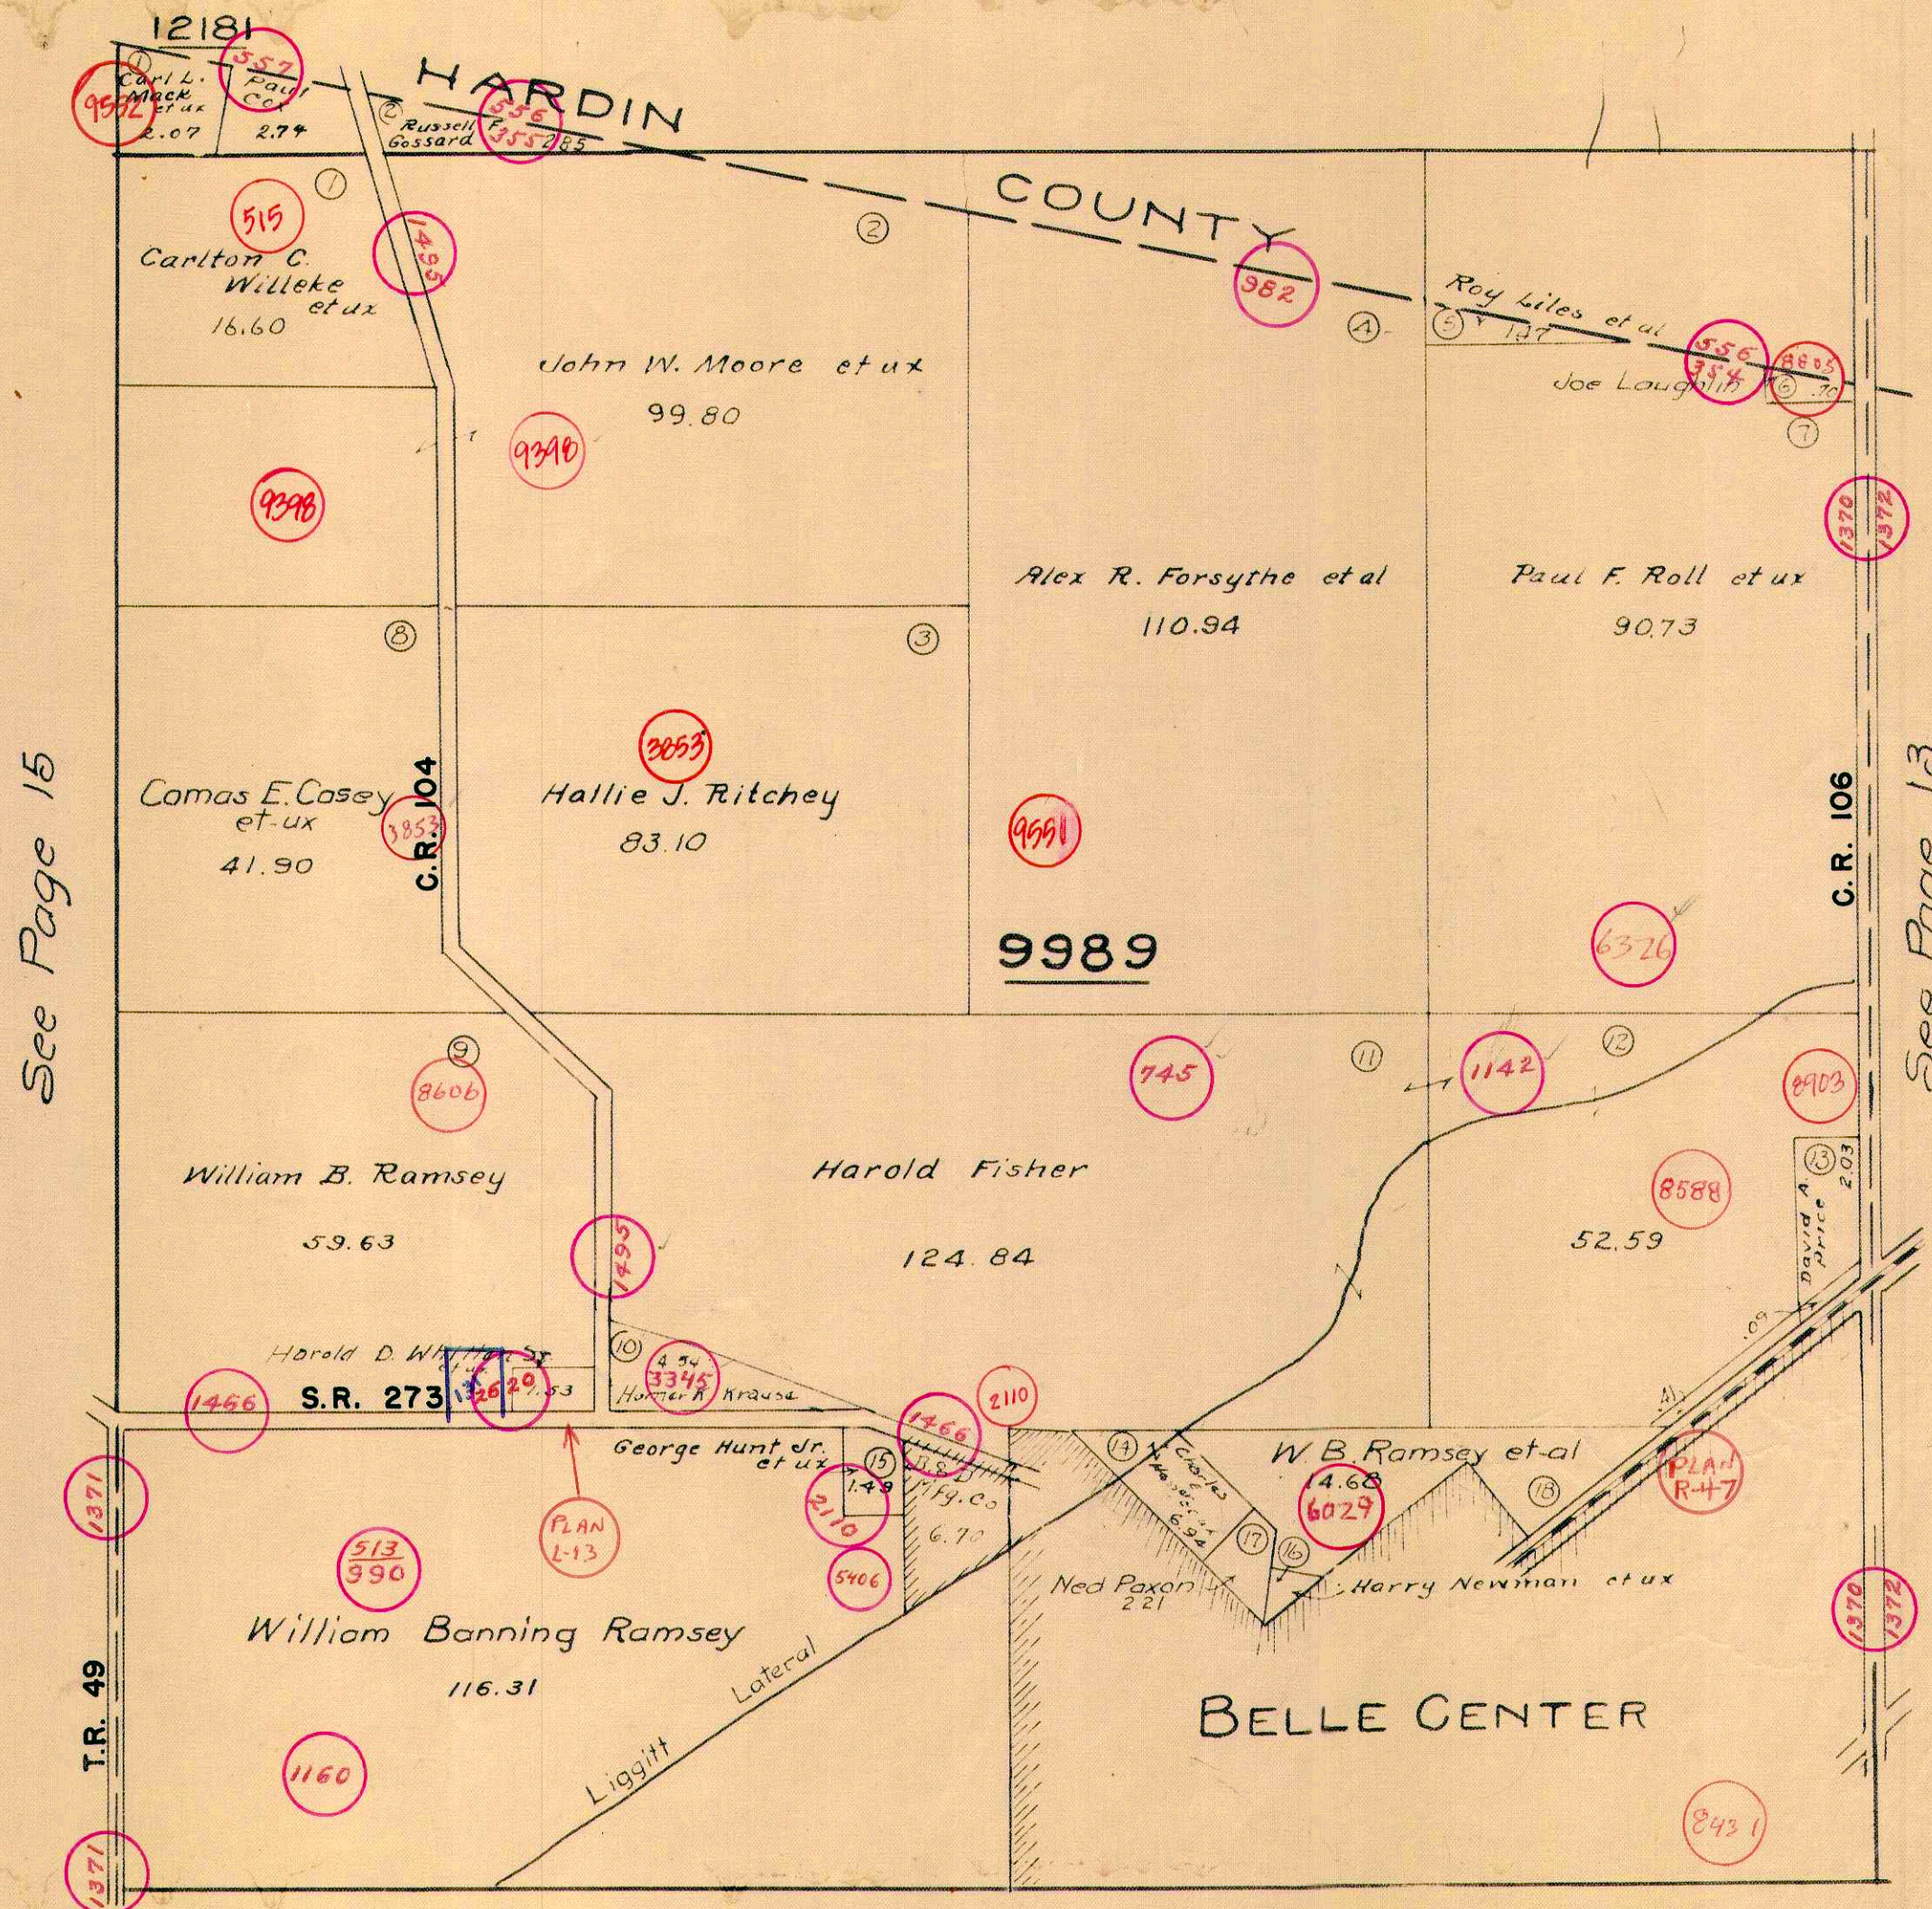

See Page 15

See Page 13

See Page 11