


RUSHCREEK TOWNSHIP
 VIRGINIA MILITARY SURVEYS

10502
 13079

PAGE

SCALE 10 CHAINS TO THE INCH

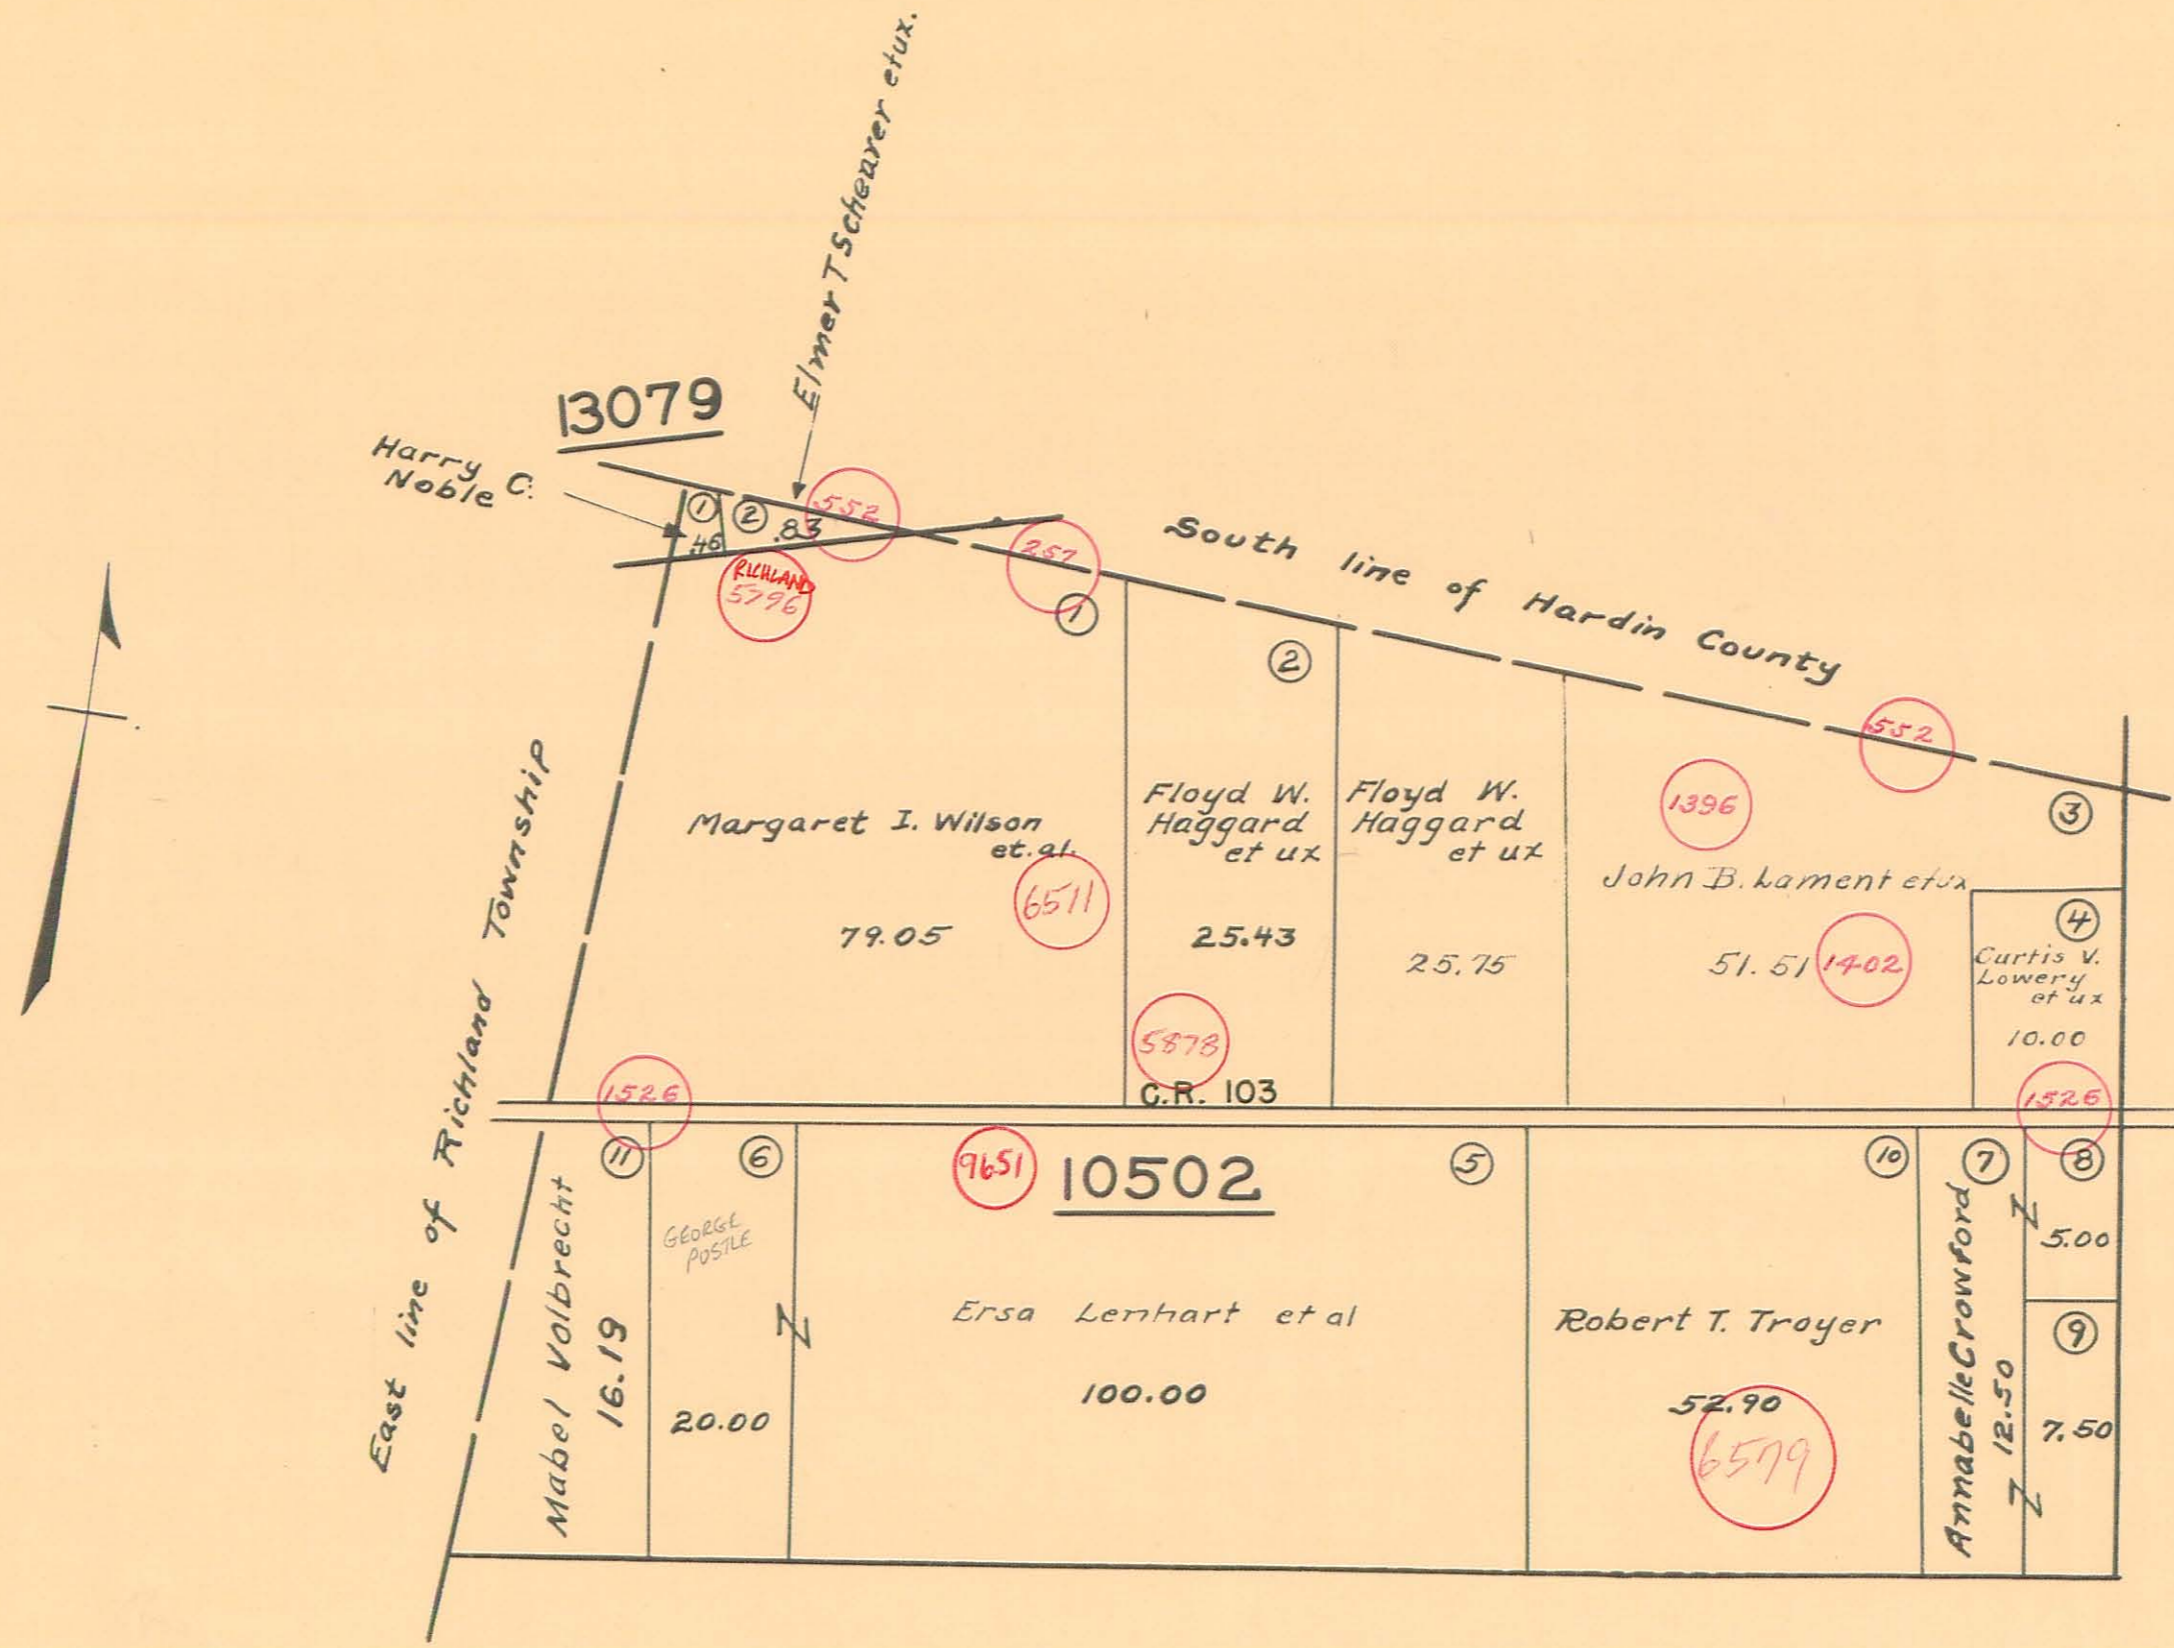

(See Page 4)

(See Page 2)