


STOKES TOWNSHIP
SECTION 14 TOWN 6 S. RANGE 8 E.

SCALE 10 CHAINS TO THE INCH

See Page 4

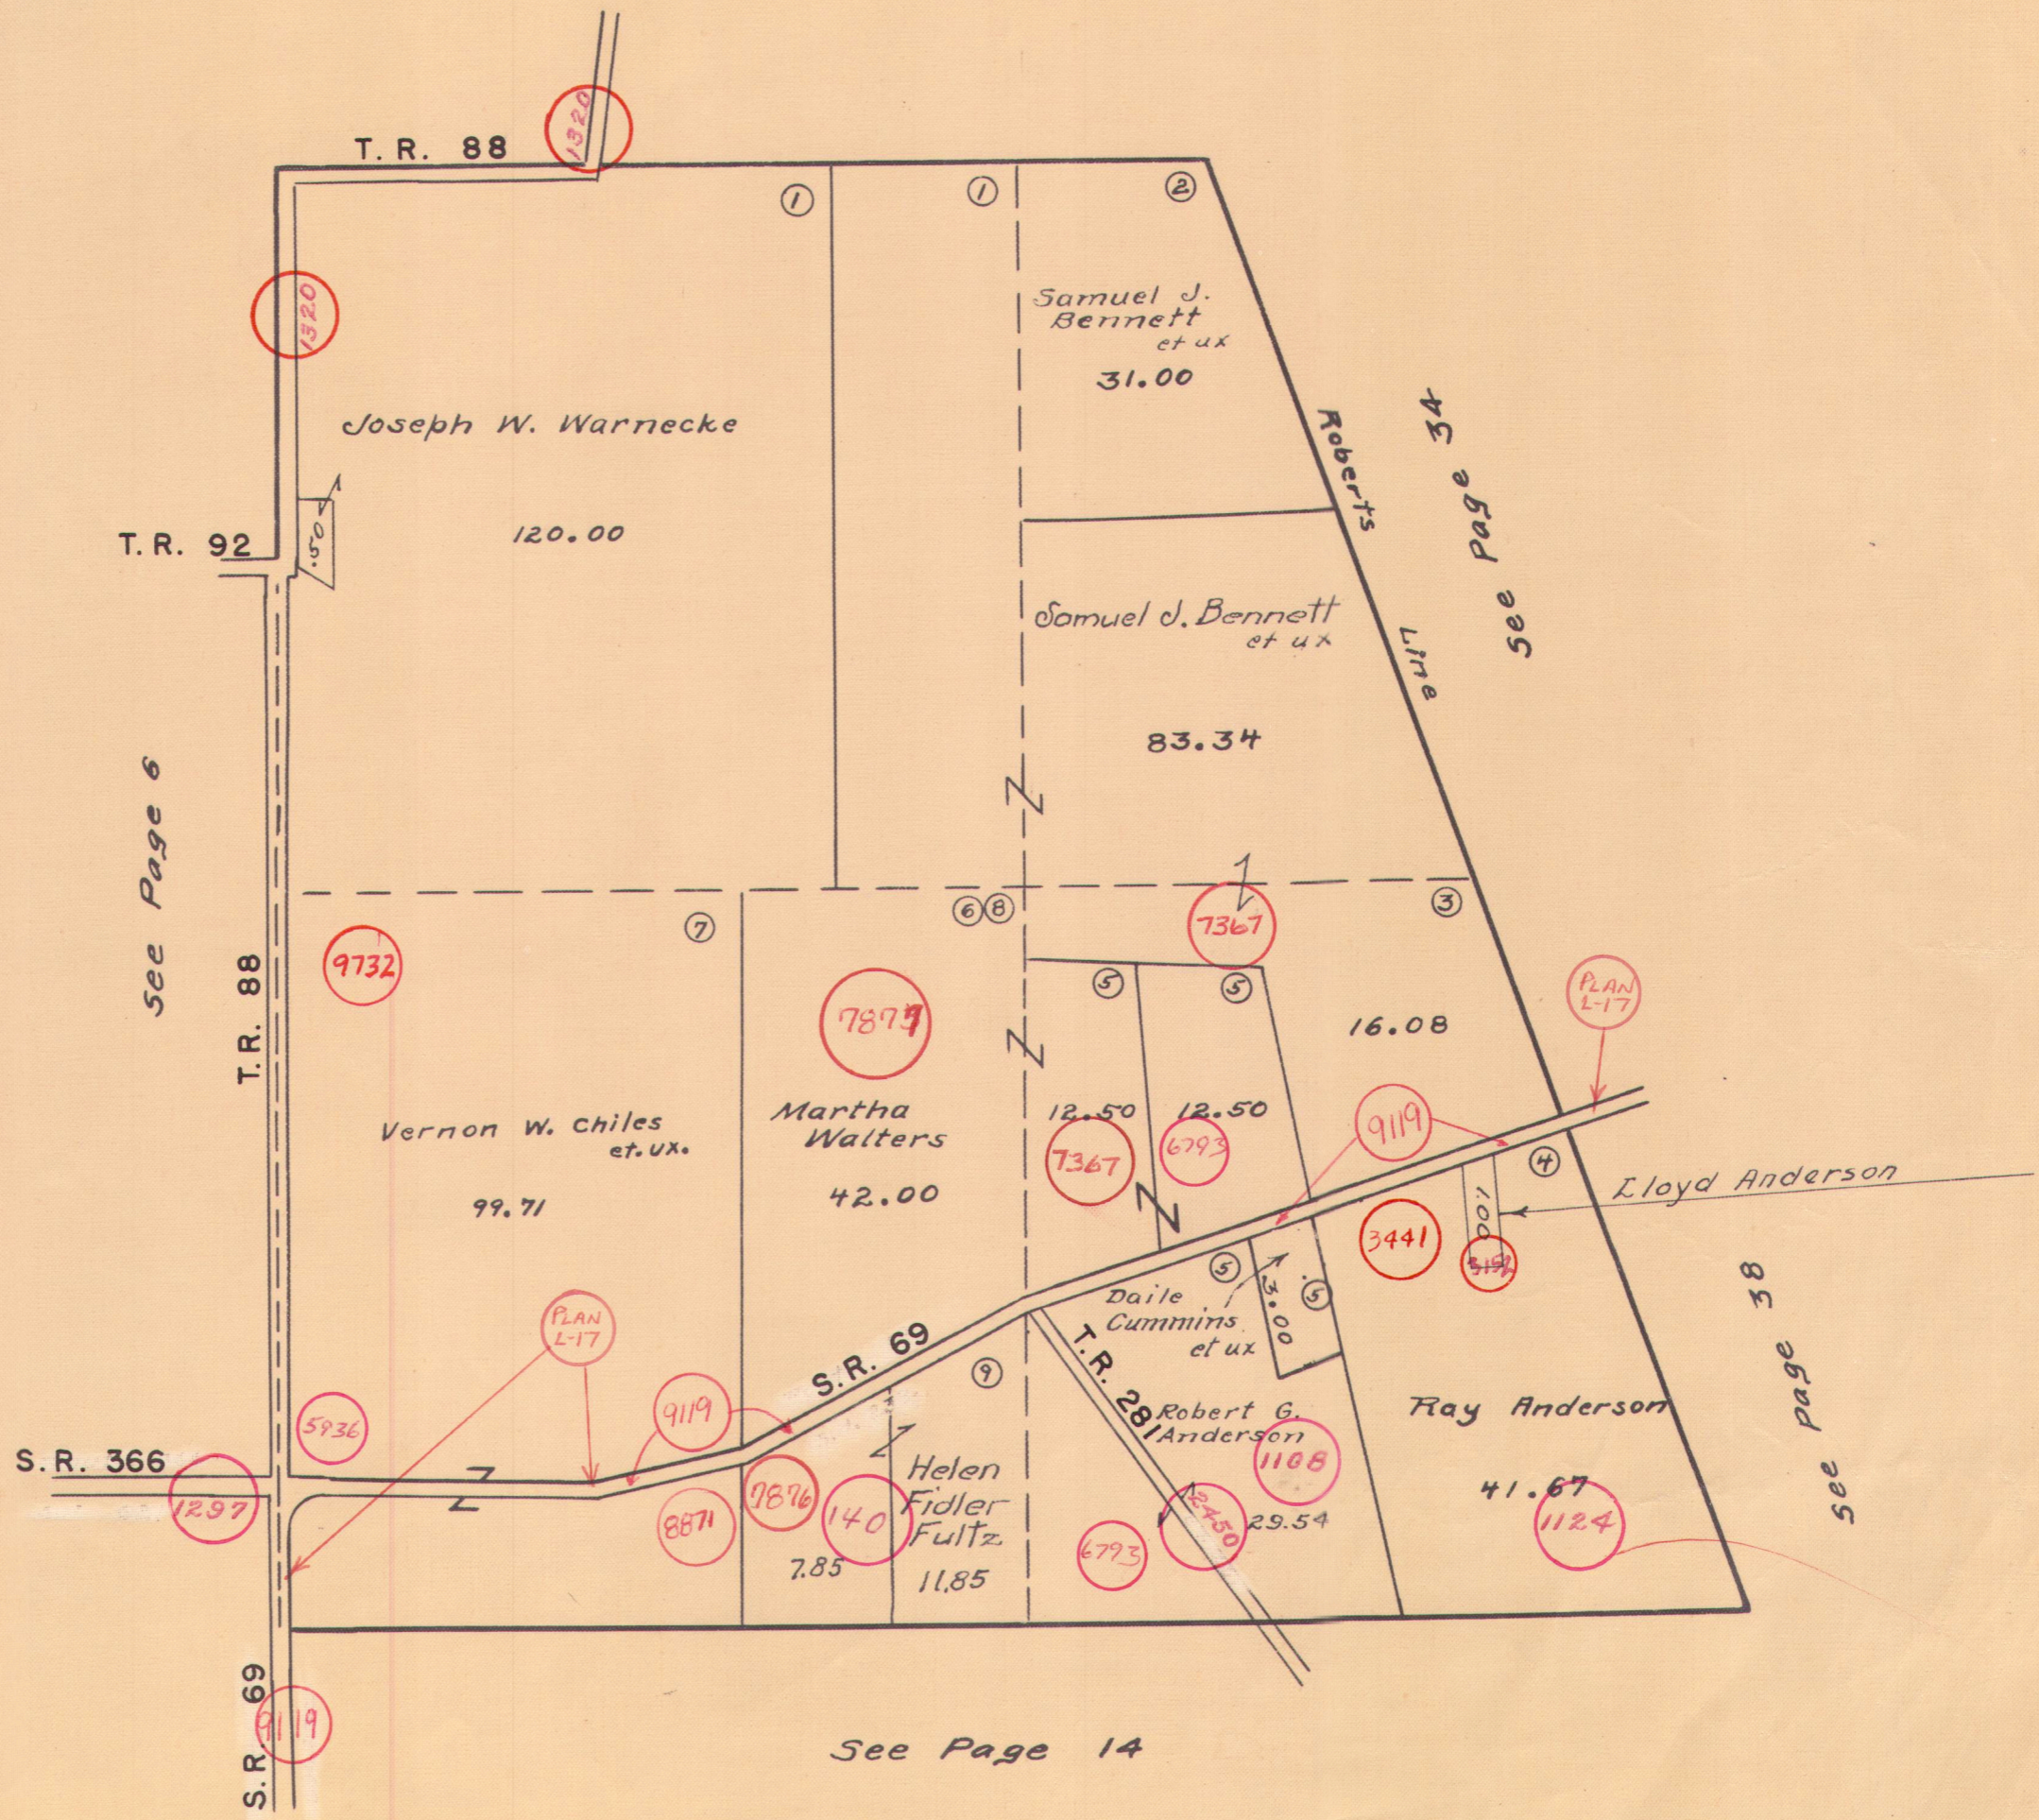

See Page 6

See Page 34

see page 38

See Page 14

F. H. Wright