STOKES TOWNSHIP

VIRGINIA MILITARY SURVEY 12276
VIRGINIA MILITARY SURVEY 12277

SCALE 60 FEET TO THE INCH

TURKEY FOOT (PART)
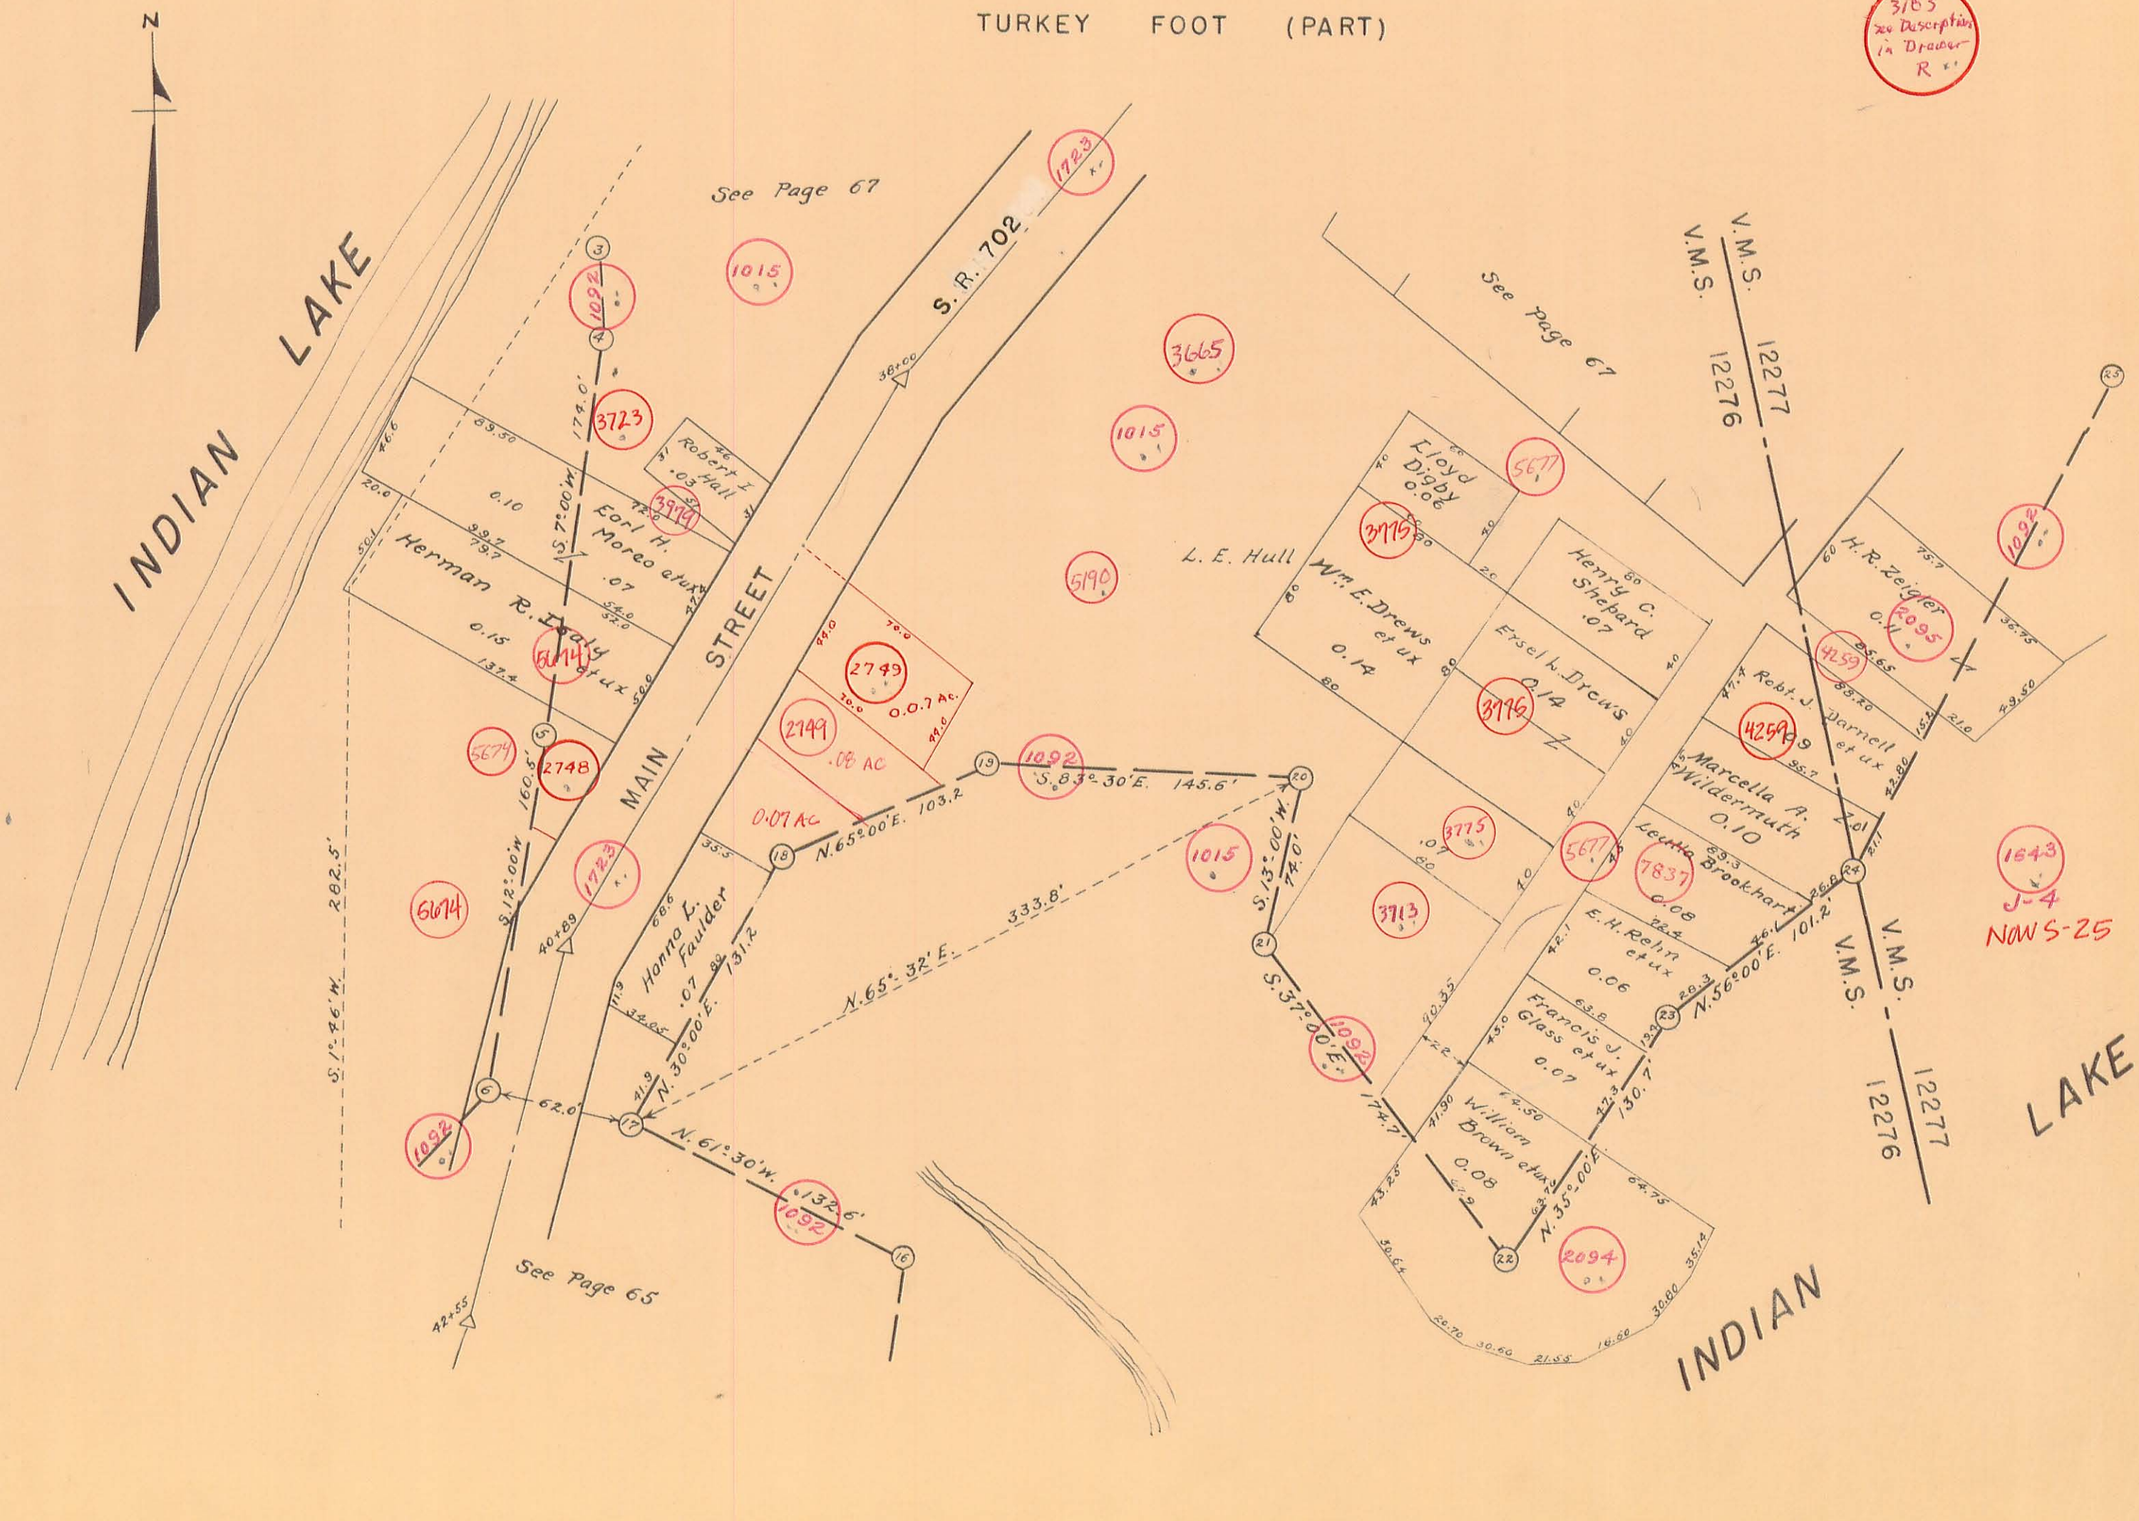
3183
see Description
in Drawer
R