WASHINGTON TOWNSHIP

VIRGINIA MILITARY SURVEY

9925
9946
10121

WATERBURY ALLOTMENT LOTS 1 TO 227

SCALE 200 FEET TO THE INCH
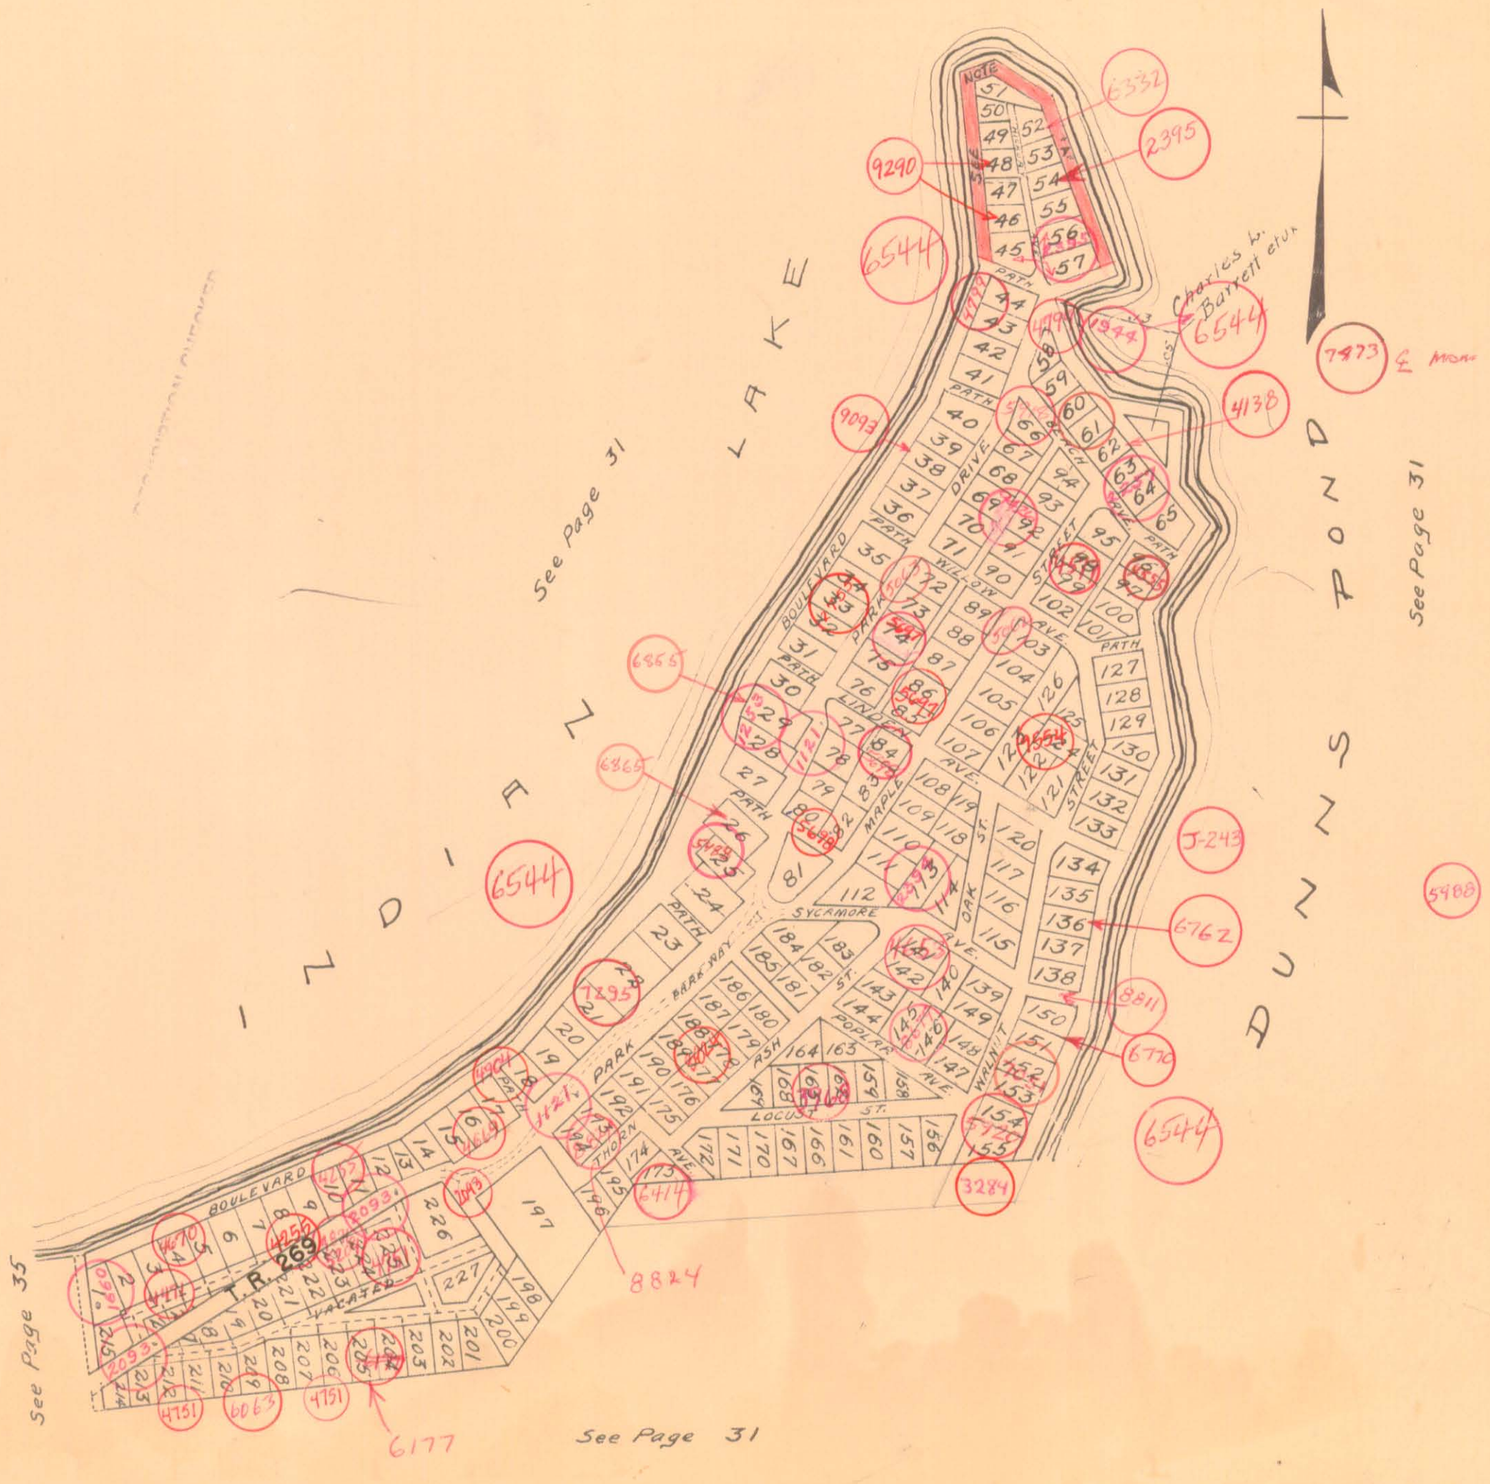
SEE R-2395 FOR PROSECUTING ATTORNEY'S OPINION ON PATHS AND WALKWAYS