

SCALE: 100' = 1"


SMITH ALLOTMENTS (4044)

See Page 34

See Page 35

See Page 31

See Page 36

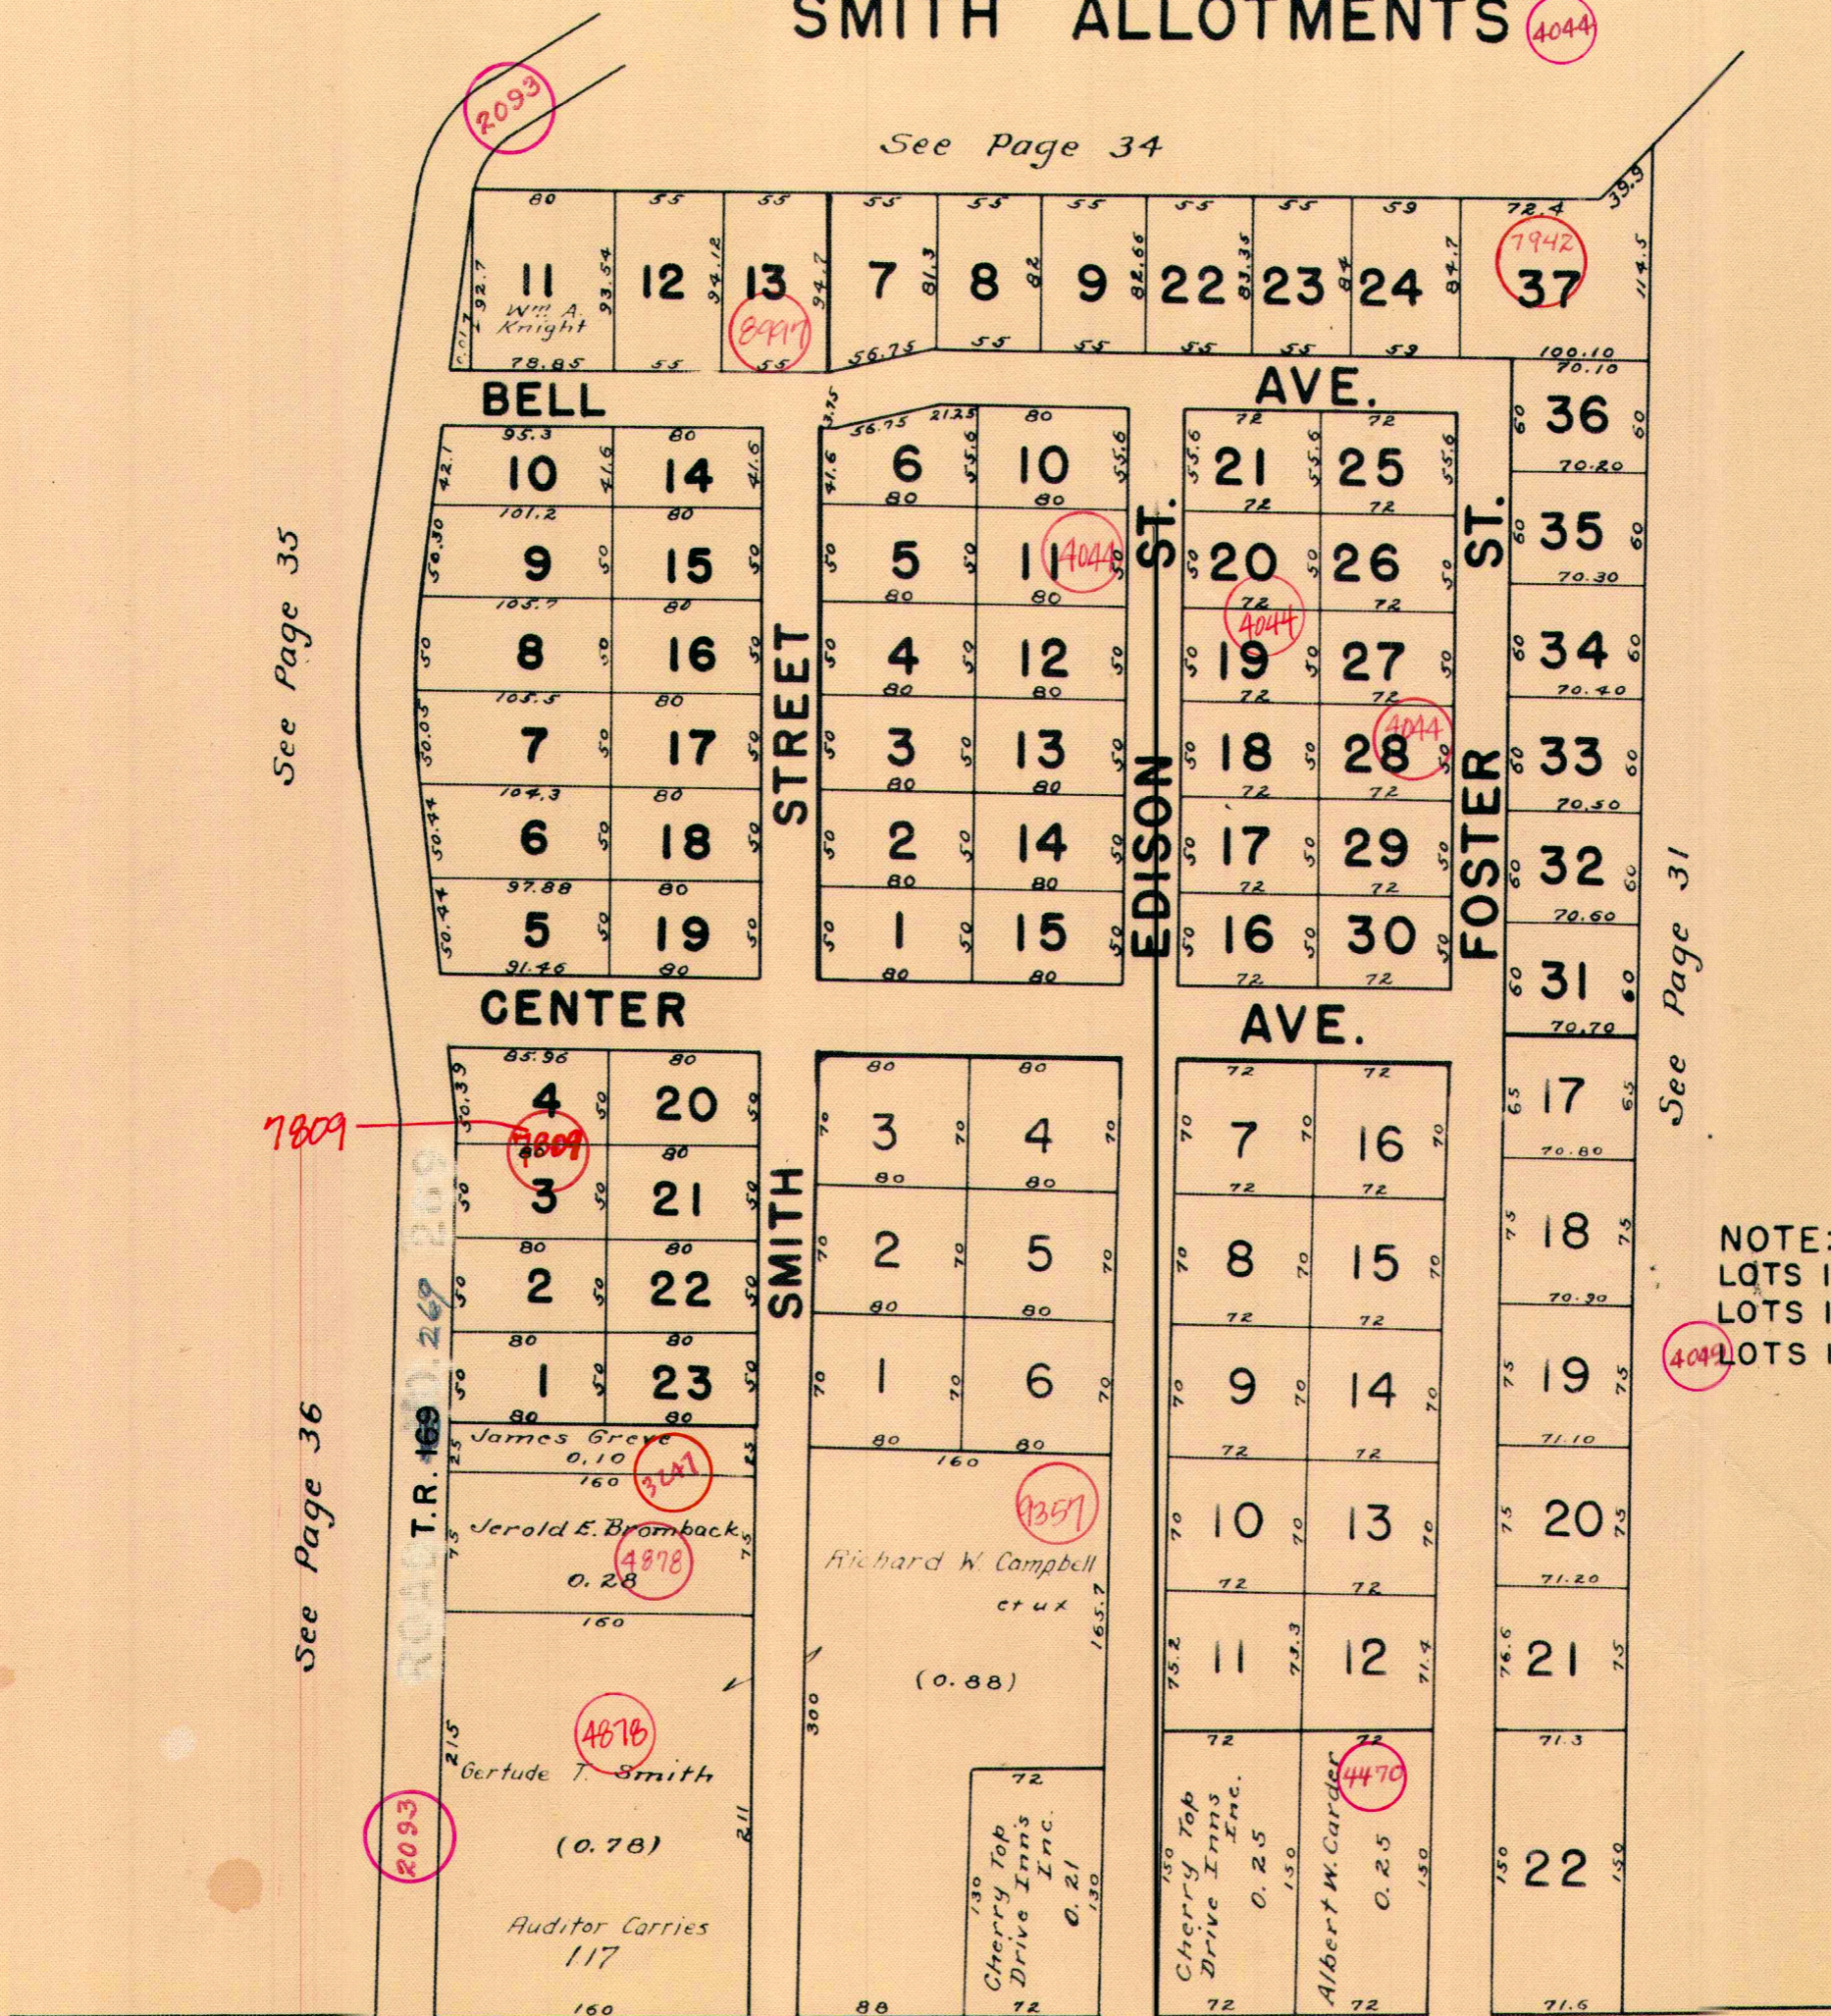

NOTE:
LOTS 1 TO 23 SMITH ALLOTMENT NO. 1
LOTS 1 TO 37 SMITH ALLOTMENT NO. 2 (1088)
LOTS 1 TO 22 SMITH ALLOTMENT NO. 3 (4044)