


WASHINGTON TOWNSHIP
SECTION 1 TOWN 7 RANGE 8
RUSSELLS POINT

SCALE 1 INCH = 100 FEET

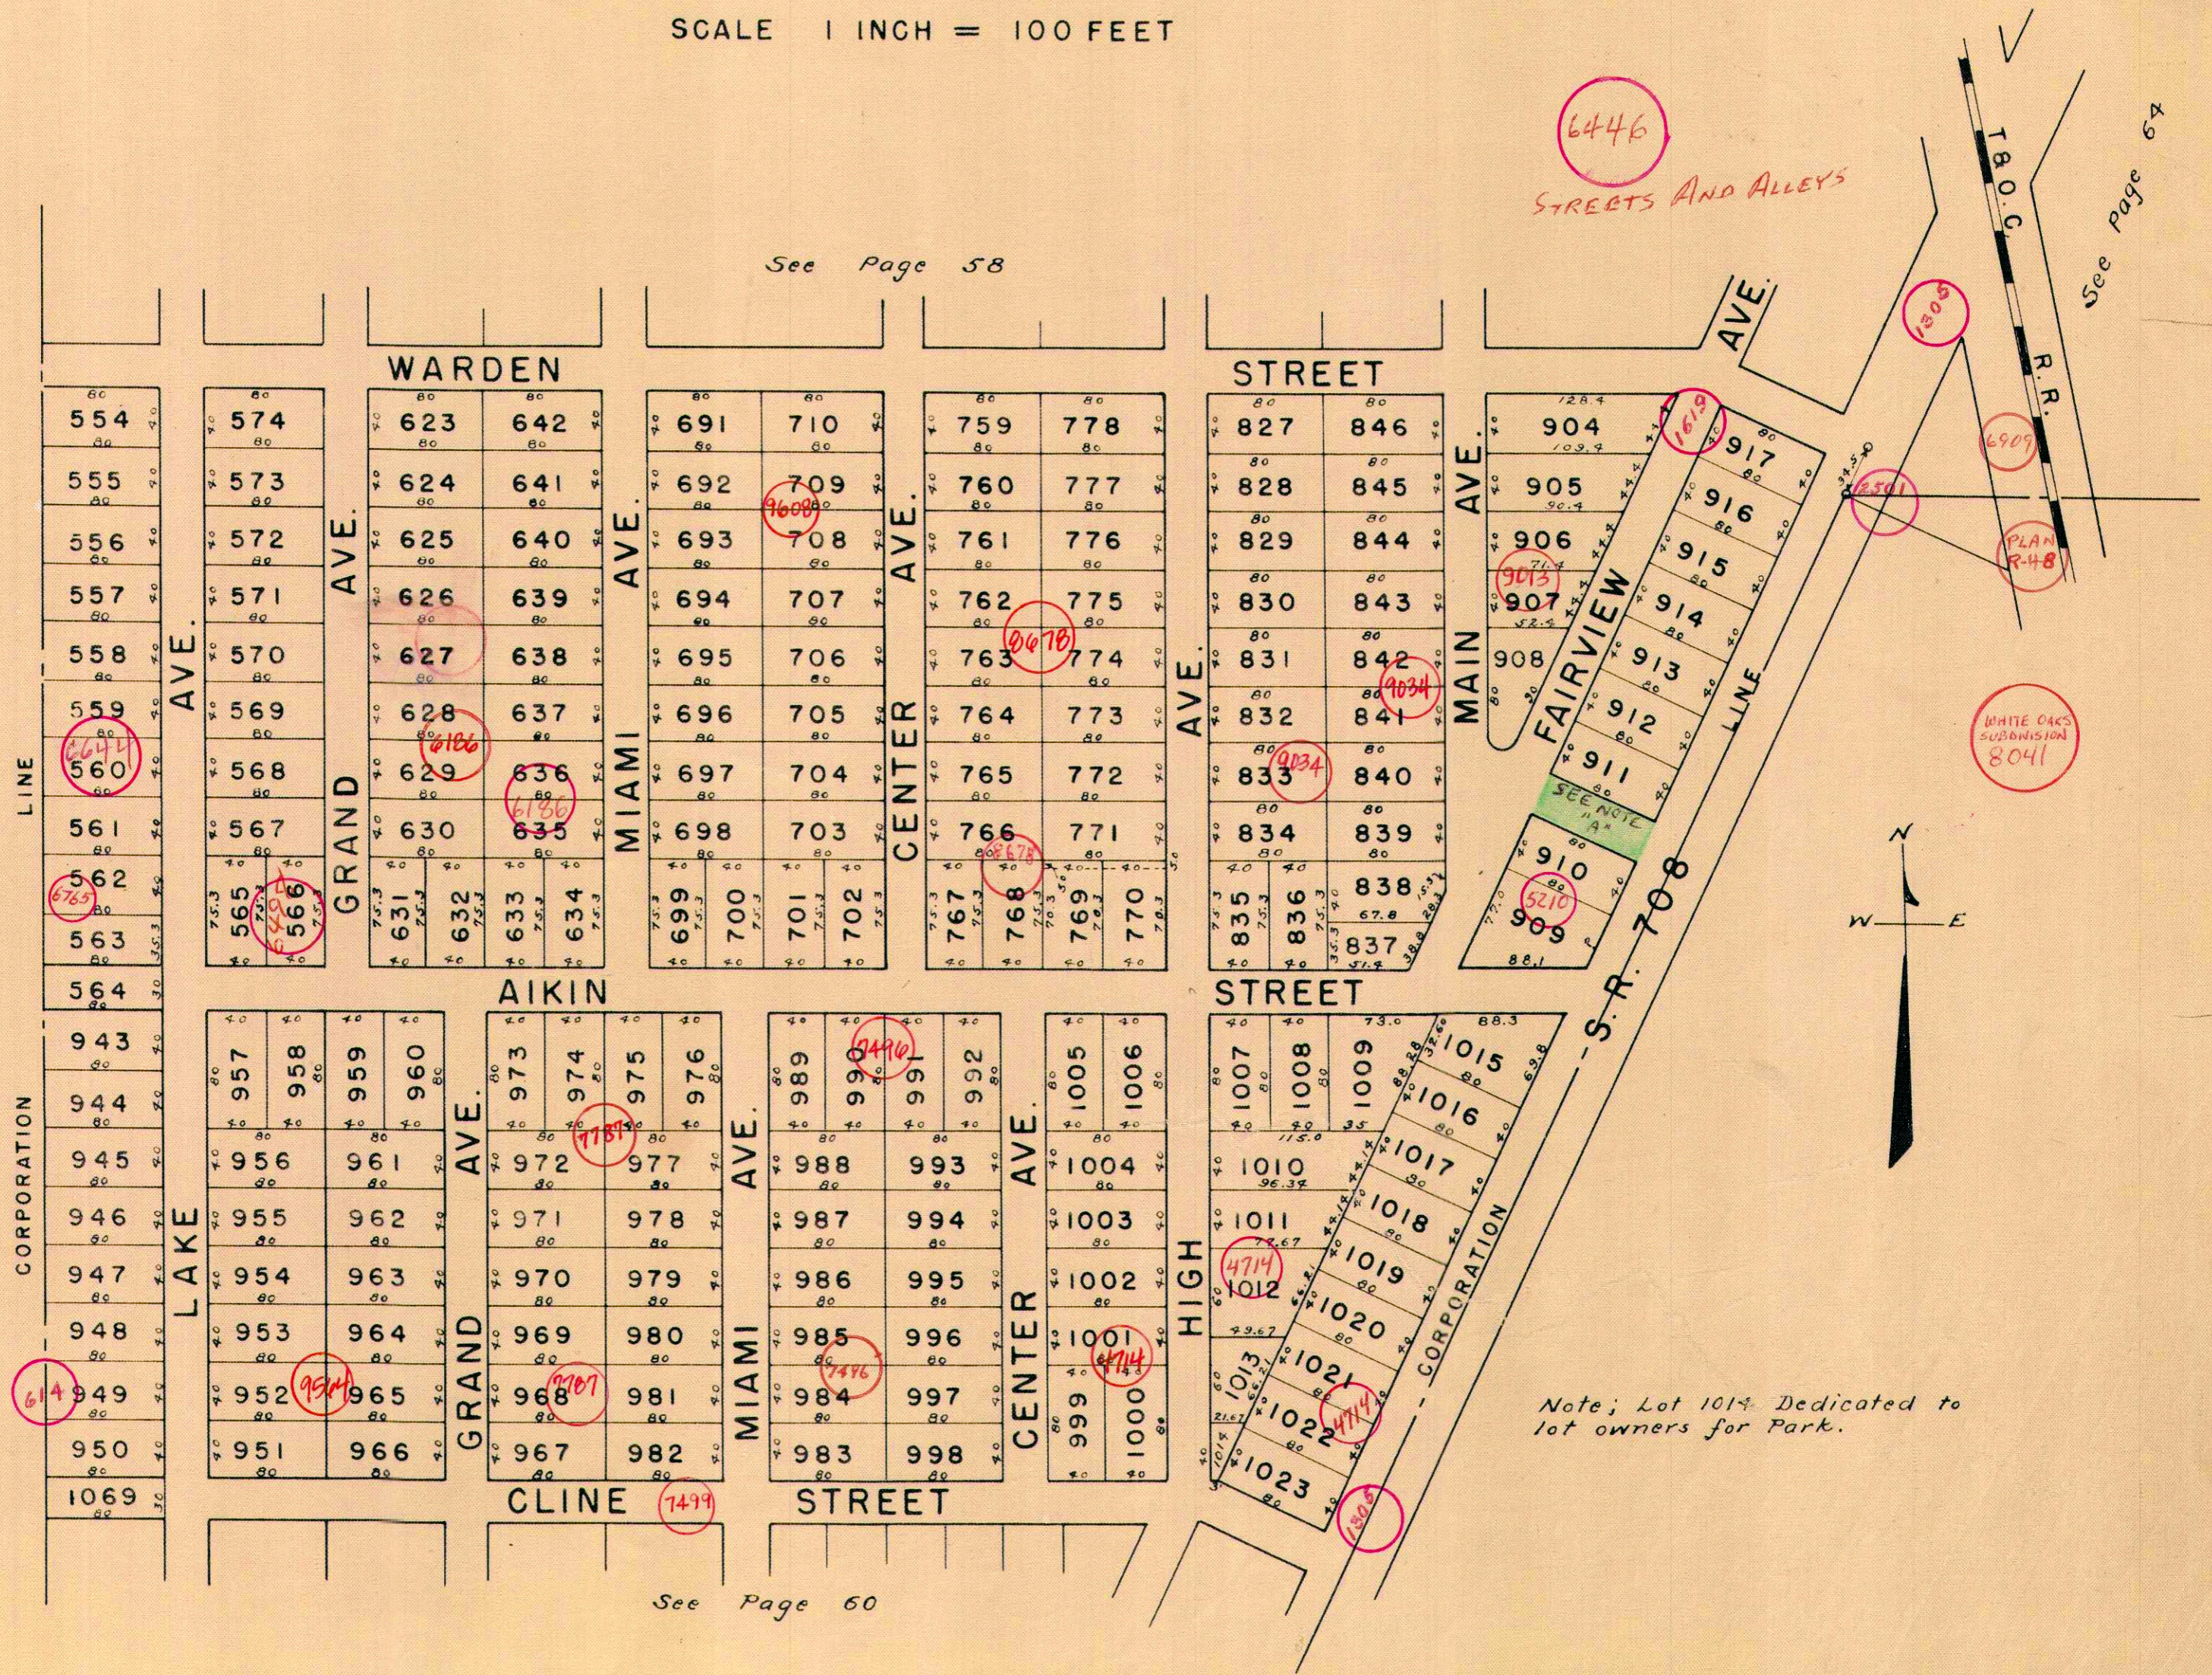

LINE
CORPORATION

LAKE AVE.

GRAND AVE.

MIAMI AVE.

MIAMI AVE.

