


WASHINGTON TOWNSHIP
SECTION 36 TOWN 6 RANGE 8

RUSSELLS POINT
SCALE 1 INCH = 100 FEET

6446
STREETS AND ALLEYS

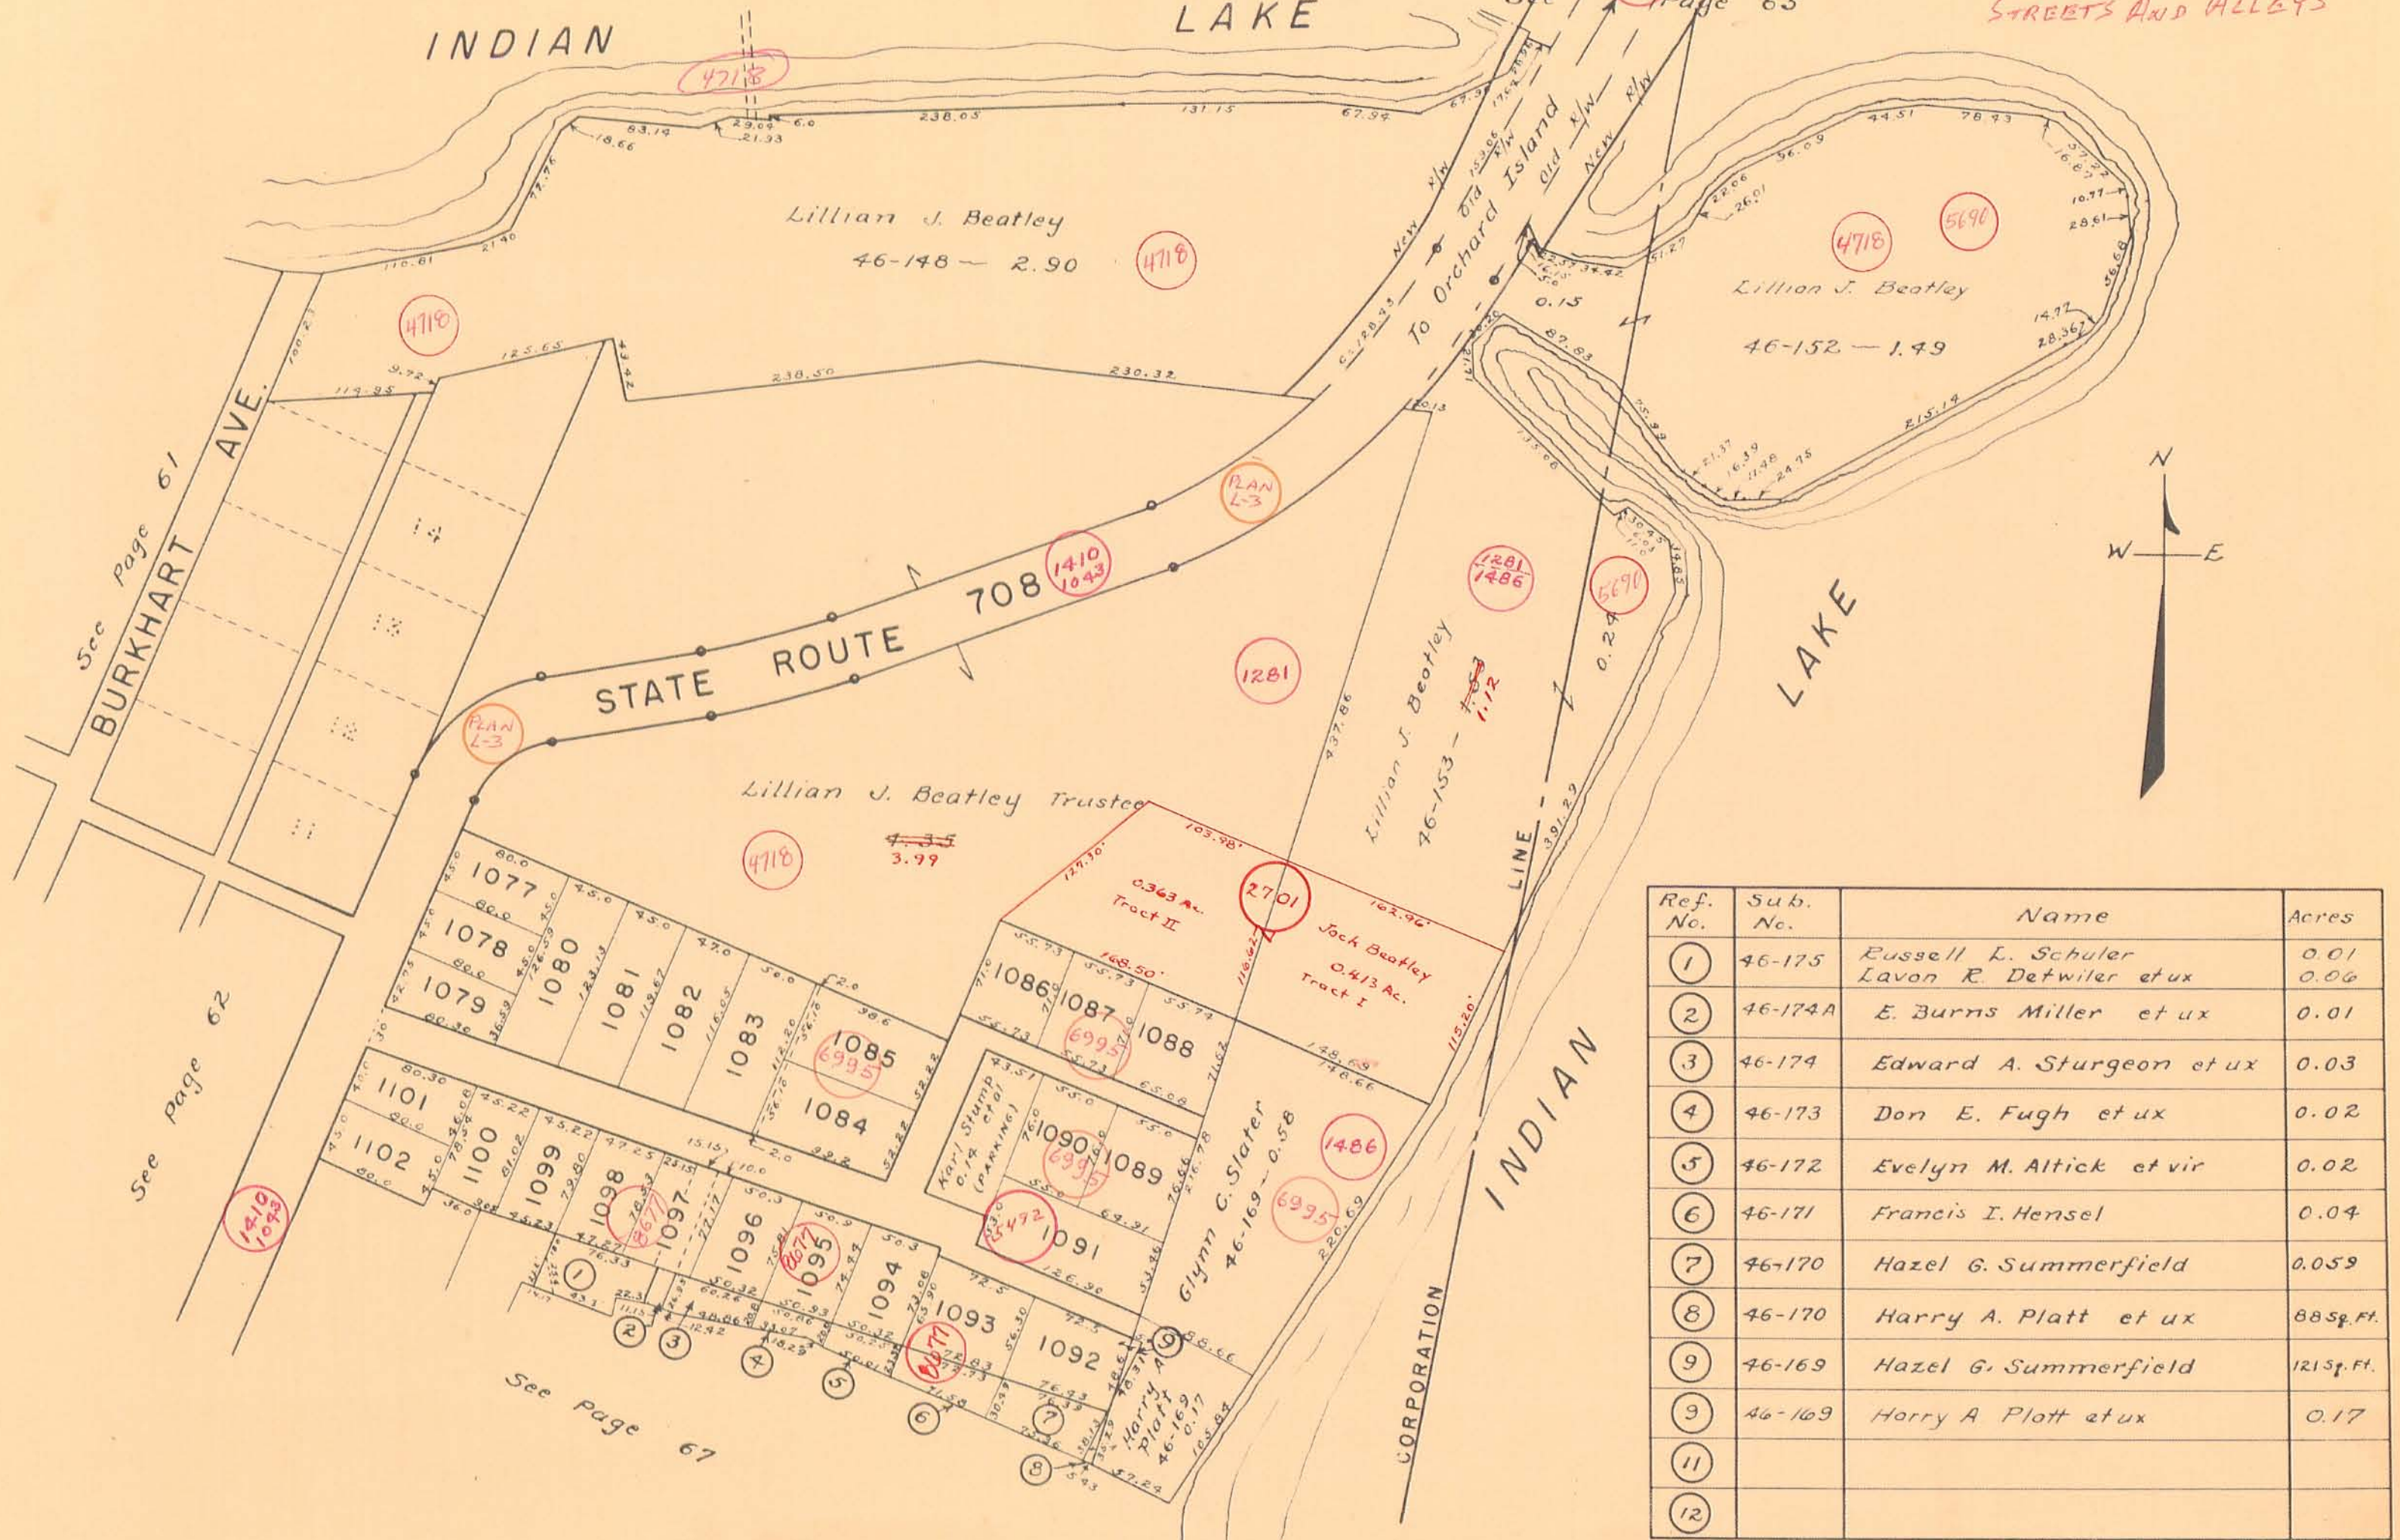

Ref. No.	Sub. No.	Name	Acres
1	46-175	Russell L. Schuler Lavon R. Detwiler et ux	0.01 0.06
2	46-174A	E. Burns Miller et ux	0.01
3	46-174	Edward A. Sturgeon et ux	0.03
4	46-173	Don E. Fugh et ux	0.02
5	46-172	Evelyn M. Altick et vir	0.02
6	46-171	Francis I. Hensel	0.04
7	46-170	Hazel G. Summerfield	0.059
8	46-170	Harry A. Platt et ux	88 Sq. Ft.
9	46-169	Hazel G. Summerfield	1215 Sq. Ft.
9	46-169	Harry A. Platt et ux	0.17
11			
12			