


ZANE TOWNSHIP
 VIRGINIA MILITARY SURVEY 4953

SCALE 10 CHAINS TO THE INCH

(See Page 14)

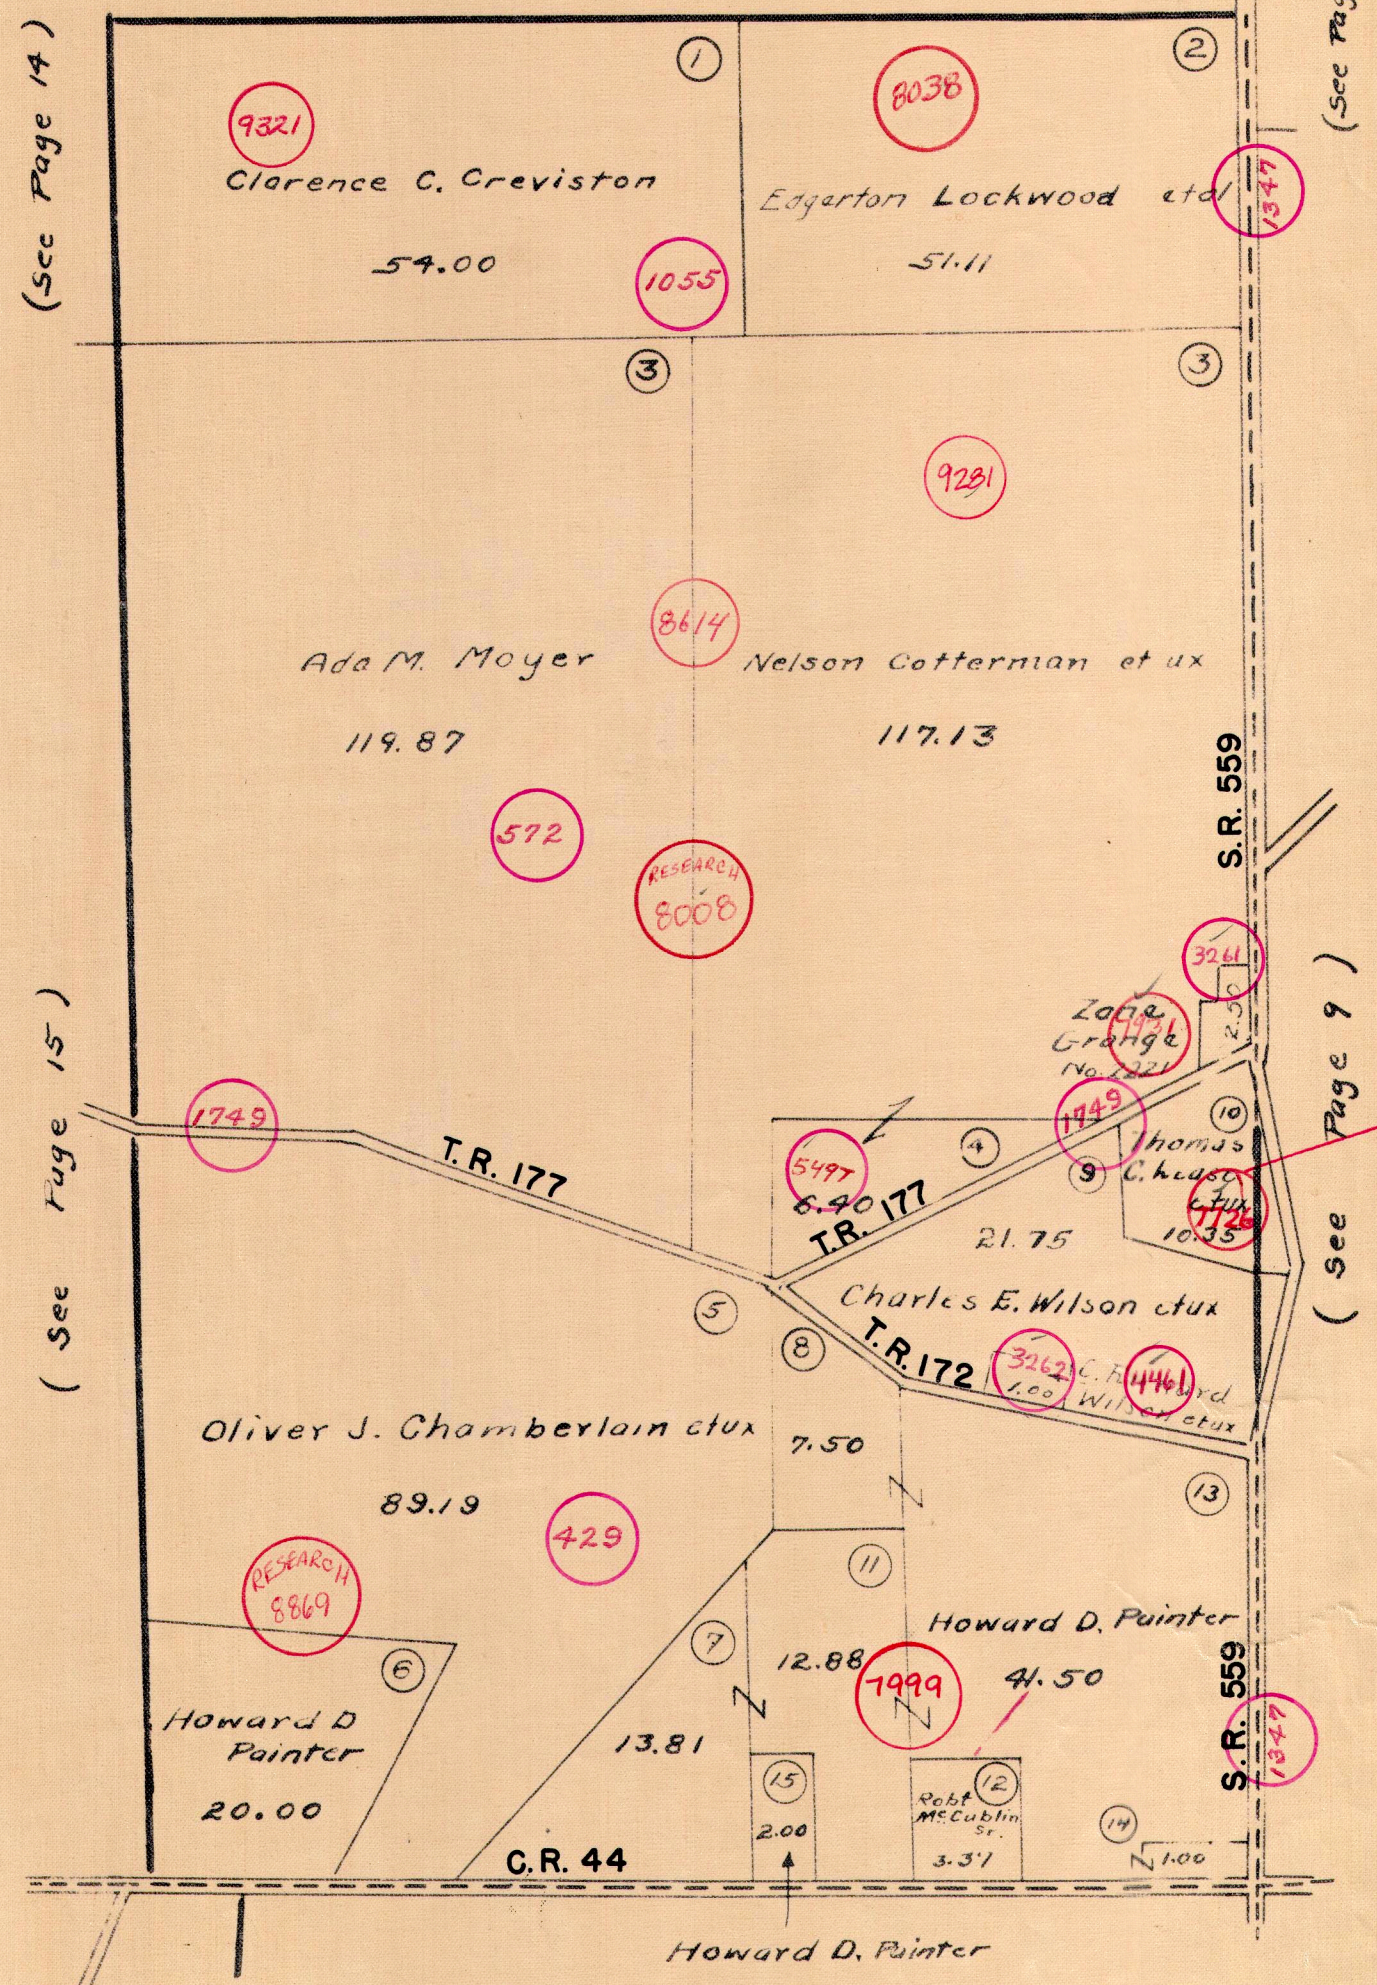

(See Page 14)

(See Page 8)

(See Page 15)

(See Page 9)

(See Page 20)