ROAD NO 247
WASHINGTON TOWNSHIP
LOGAN COUNTY
1933

1/2

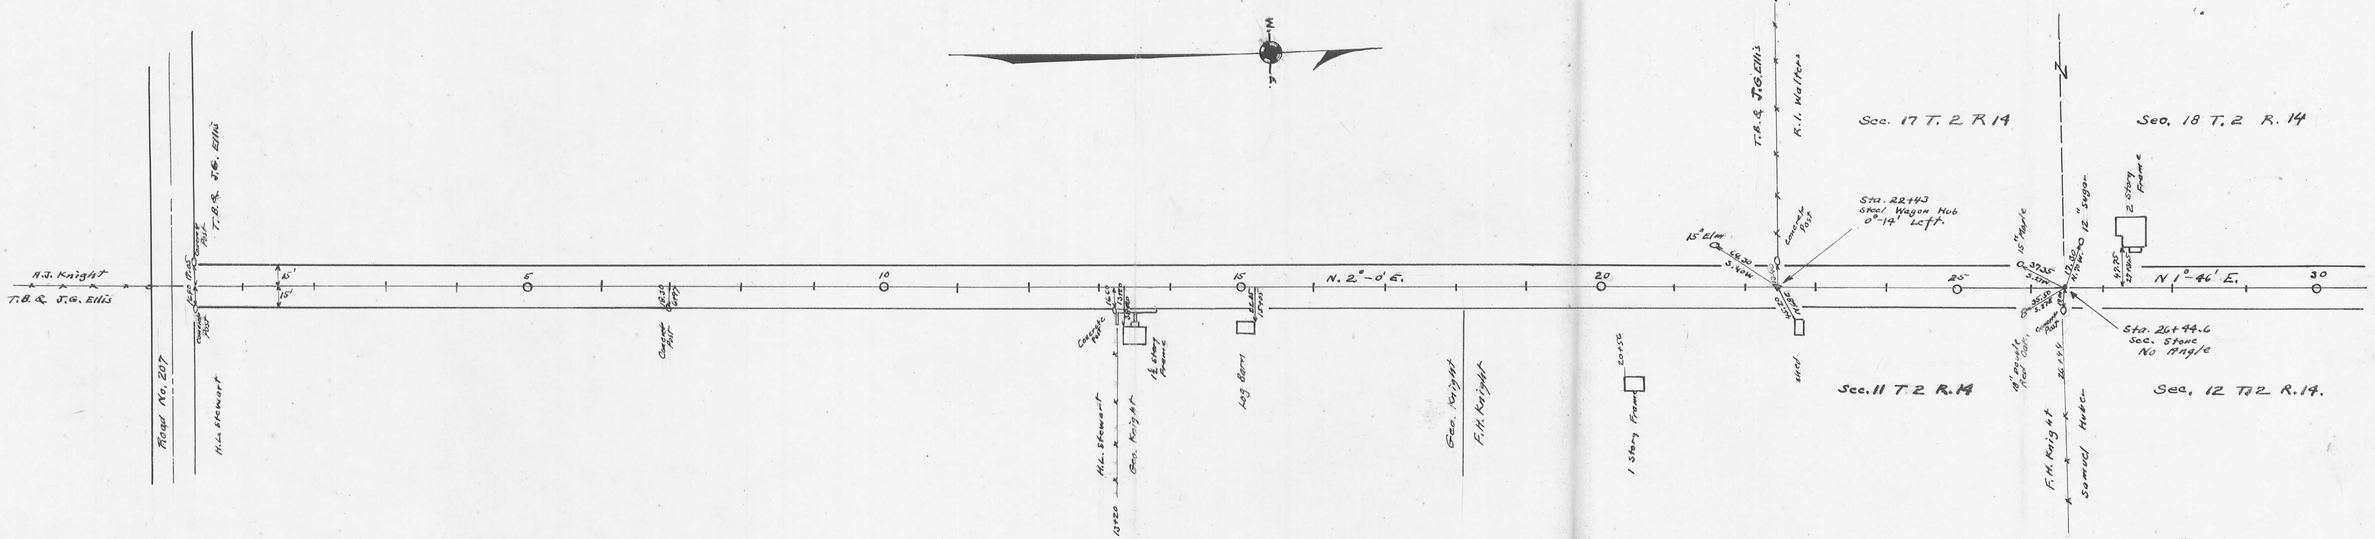

Field Notes Book 57/
30' Road. Road Record No. 1
Pages 20-77-78
June 1857

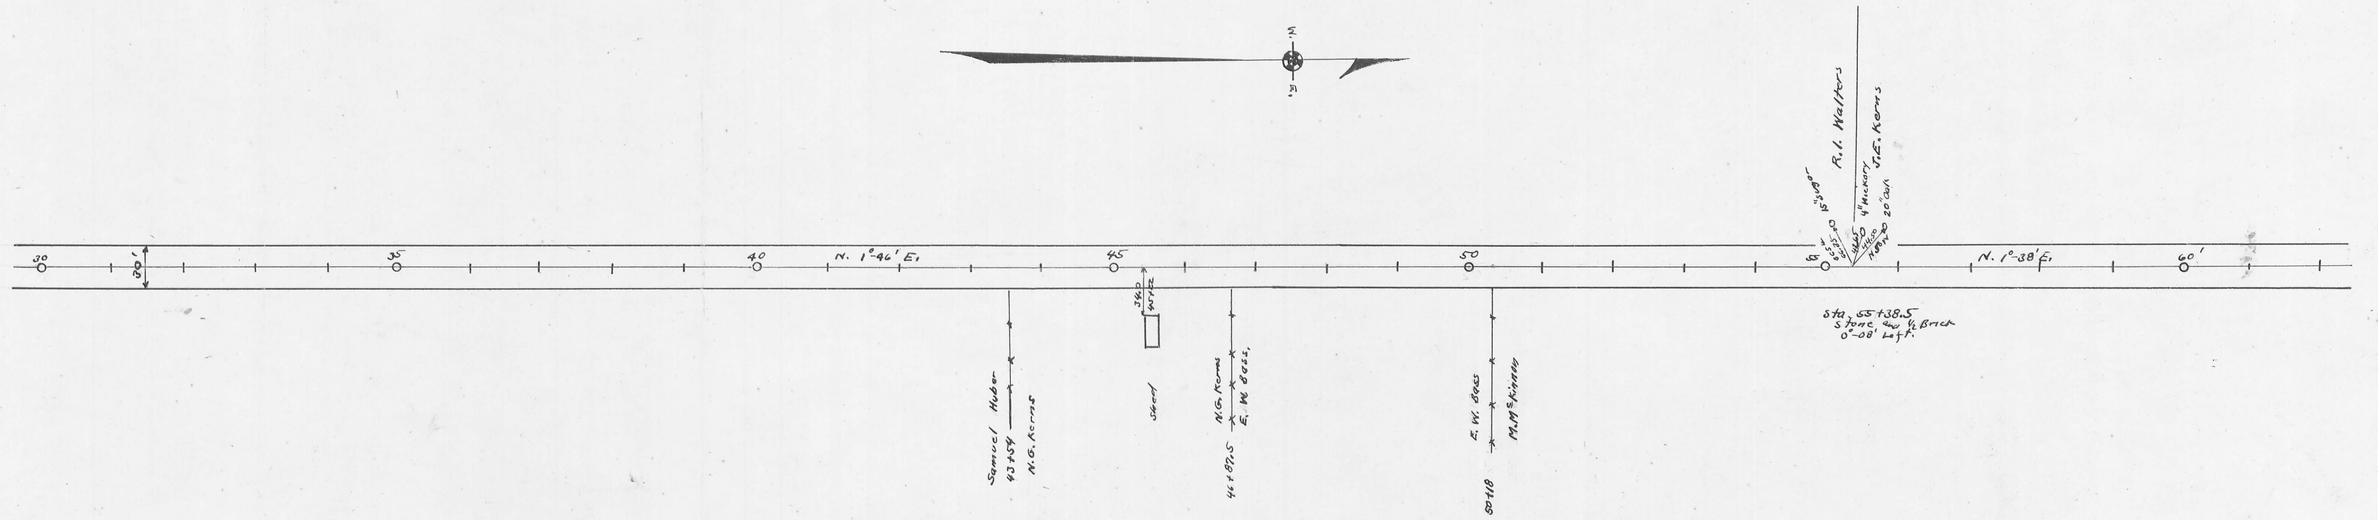

F.F. Wright
1933

(1499)
INDEXED ON MAP.

X-247

ROAD NO 247
WASHINGTON TOWNSHIP
LOGAN COUNTY
1933

2/2

Length 8297 Feet
Length 1.5714 Miles

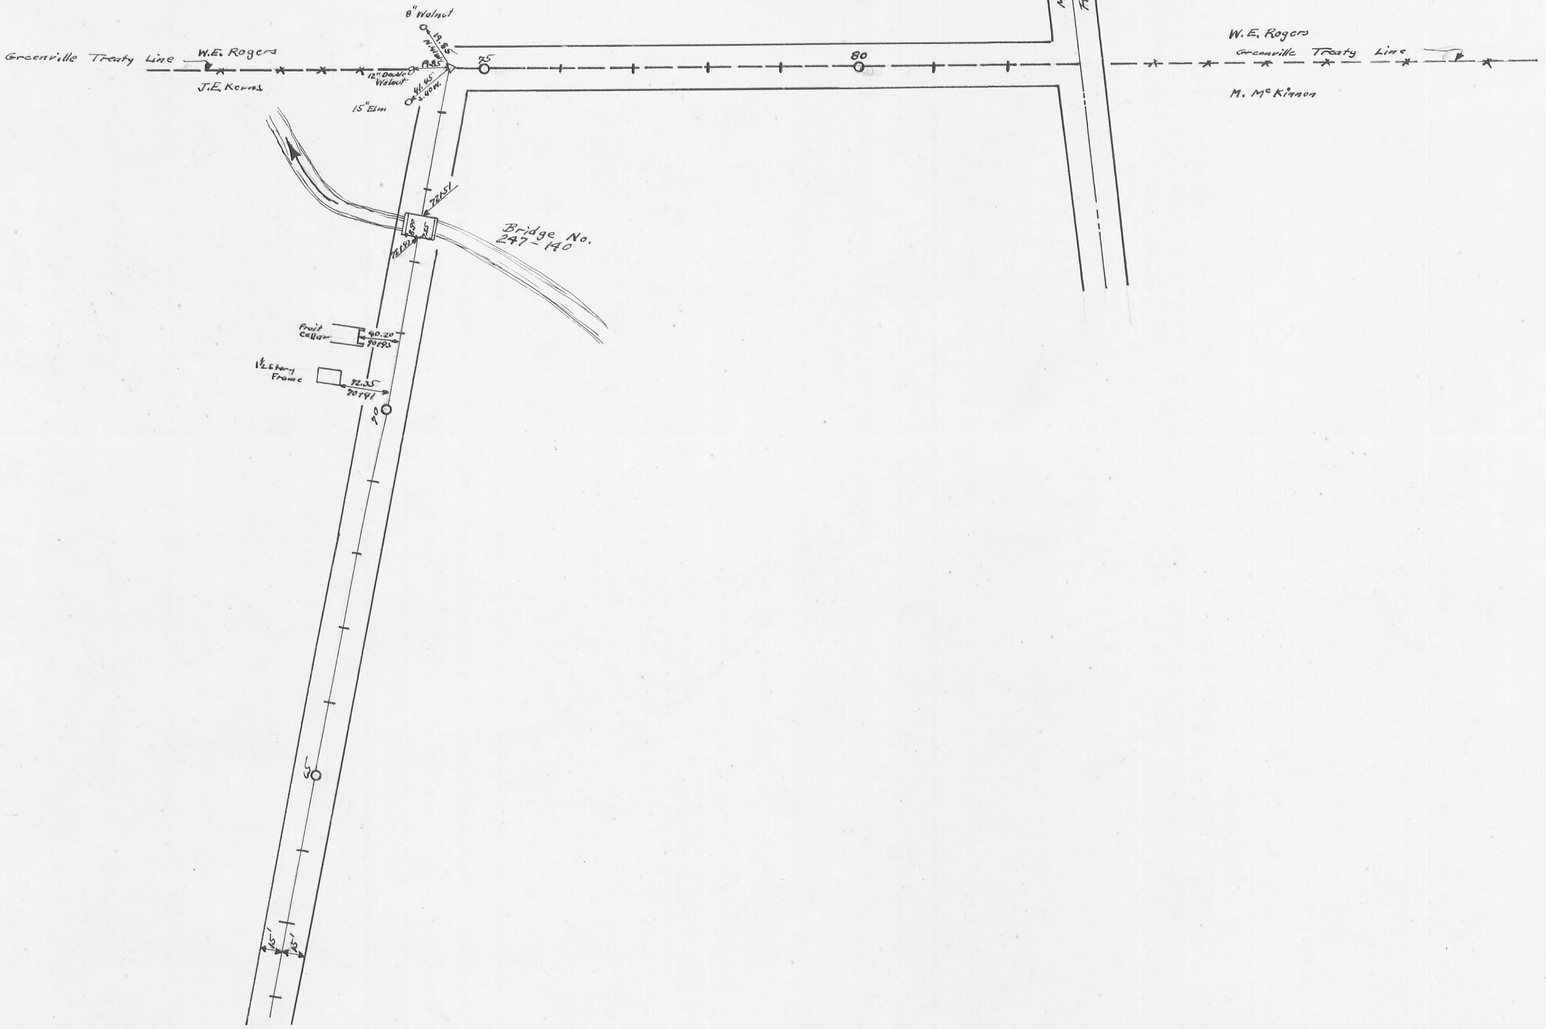

Field Notes Book 591

F.F. Wright
1933

1499
INDEXED ON MAP

X-247